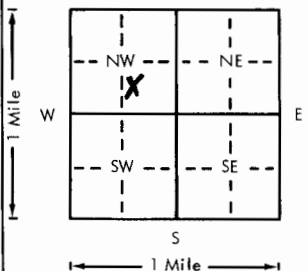


USE TYPEWRITER OR BALL
POINT PEN-PRESS FIRMLY,
PRINT CLEARLY.

WATER WELL RECORD
KSA 82a-1201-1215

Kansas Department of Health and
Environment-Division of Environment
(Water well Contractors)
Topeka, Kansas 66620

1. Location of well:		County BUTLER	Fraction NW 1/4 SE 1/4 NW 1/4	Section number 17	Township number T 23-S	Range number R 3-E	E/W
2. Distance and direction from nearest town or city:				3. Owner of well: Floyd Zuercher			
Street address of well location if in city:				R.R. or street:			
				City, state, zip code: Elbing, Kansas			
4. Locate with "X" in section below:				Sketch map:			
							
5. Type and color of material				From	To	6. Bore hole dia. 8 in. Completion date 9-9-78 Well depth 65 ft.	
CLAY - BROWN				0	95	7. <input checked="" type="checkbox"/> Cable tool <input checked="" type="checkbox"/> Rotary <input type="checkbox"/> Driven <input type="checkbox"/> Dug <input type="checkbox"/> Hollow rod <input type="checkbox"/> Jetted <input type="checkbox"/> Bored <input type="checkbox"/> Reverse rotary	
LOOSE CLAY & COARSE GRAVEL				45	65	8. Use: <input type="checkbox"/> Domestic <input type="checkbox"/> Public supply <input type="checkbox"/> Industry <input checked="" type="checkbox"/> Irrigation <input type="checkbox"/> Air conditioning <input type="checkbox"/> Stock <input checked="" type="checkbox"/> Lawn <input type="checkbox"/> Oil field water <input type="checkbox"/> Other	
						9. Casing: Material Plastic Height: Above or below Threaded <input type="checkbox"/> Welded <input type="checkbox"/> Surface 18 in. RMP <input checked="" type="checkbox"/> PVC <input type="checkbox"/> Weight <input type="checkbox"/> lbs./ft. Dia. 5 in. to 45 ft. depth Wall Thickness: inches or Dia. <input type="checkbox"/> in. to <input type="checkbox"/> ft. depth gage No. 200	
						10. Screen: Manufacturer's name Sunflower Plastic Pipe Type 200 Dia. 5" Slot/gauze Slot 1/8 Length 20' Set between 45 ft. and 65 ft. Gravel pack? Yes Size range of material 7/4-1/2	
						11. Static water level: 25 ft. below land surface Date 9-9-78 mo./day/yr.	
						12. Pumping level below land surfaces: 30 ft. after 2 hrs. pumping 35 g.p.m. ft. after <input type="checkbox"/> hrs. pumping <input type="checkbox"/> g.p.m. Estimated maximum yield 25 g.p.m.	
						13. Water sample submitted: <input type="checkbox"/> Yes <input checked="" type="checkbox"/> No Date <input type="checkbox"/>	
						14. Well head completion: <input type="checkbox"/> Pitless adapter 18 inches above grade	
						15. Well grouted? Yes With: <input type="checkbox"/> Neat cement <input type="checkbox"/> Bentonite <input checked="" type="checkbox"/> Concrete Depth: From 0 ft. to 10 ft.	
						16. Nearest source of possible contamination: ft. 75' Direction W Type SEWER LINES Well disinfected upon completion? <input type="checkbox"/> Yes <input checked="" type="checkbox"/> No	
						17. Pump: <input checked="" type="checkbox"/> Not installed Manufacturer's name <input type="checkbox"/> Model number <input type="checkbox"/> HP <input type="checkbox"/> Volts <input type="checkbox"/> Length of drop pipe <input type="checkbox"/> ft. capacity <input type="checkbox"/> g.p.m. Type: <input type="checkbox"/> Submersible <input type="checkbox"/> Turbine <input type="checkbox"/> Jet <input type="checkbox"/> Reciprocating <input type="checkbox"/> Centrifugal <input type="checkbox"/> Other	
(Use a second sheet if needed)							
18. Elevation:		19. Remarks:		20. Water well contractor's certification: This well was drilled under my jurisdiction and this report is true to the best of my knowledge and belief. Martin Supply 362 Business name License No. 500 West 22nd, N. Newton Address Signed Butch Johnson Date 9-9-78			
Topography: <input checked="" type="checkbox"/> Hill <input checked="" type="checkbox"/> Slope <input checked="" type="checkbox"/> Upland <input type="checkbox"/> Valley							