


1 LOCATION OF WATER WELL: County: <i>Butler</i>	Fraction <i>SW 1/4 NW 1/4 SE 1/4</i>	Section Number <i>25</i>	Township Number T <i>23</i> S	Range Number R <i>4</i> EW
--	---	-----------------------------	----------------------------------	-------------------------------

Distance and direction from nearest town or city street address of well if located within city?

2 WATER WELL OWNER: KEITH KOEHN, 6 North, 3 East, 2K Feeders

RR#, St. Address, Box # : 12786 NW Shumway Rd  
City, State, ZIP Code : Burns, Kans 66840-8895

3 LOCATE WELL'S LOCATION WITH AN "X" IN SECTION BOX: 4 DEPTH OF COMPLETED WELL... 82 ft. ELEVATION: 65

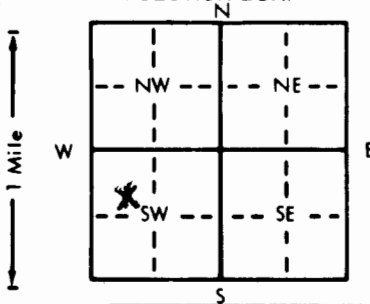

4 DEPTH OF COMPLETED WELL... 82 ft. ELEVATION: \_\_\_\_\_

Depth(s) Groundwater Encountered 1. 65 ft. 2. \_\_\_\_\_ ft. 3. \_\_\_\_\_ ft.

WELL'S STATIC WATER LEVEL 5 ft. below land surface measured on mo/day/yr 7/28/95

Pump test data: Well water was \_\_\_\_\_ ft. after \_\_\_\_\_ hours pumping \_\_\_\_\_ gpm

Est. Yield 100 gpm: Well water was \_\_\_\_\_ ft. after \_\_\_\_\_ hours pumping \_\_\_\_\_ gpm

Bore Hole Diameter 14 in. to \_\_\_\_\_ ft., and \_\_\_\_\_ in. to \_\_\_\_\_ ft.

WELL WATER TO BE USED AS:

5 Public water supply	8 Air conditioning	11 Injection well		
1 Domestic	③ Feedlot	6 Oil field water supply	9 Dewatering	12 Other (Specify below)
2 Irrigation	4 Industrial	7 Lawn and garden only	10 Monitoring well	_____

Was a chemical/bacteriological sample submitted to Department? Yes No; If yes, mo/day/yr sample was submitted \_\_\_\_\_

Water Well Disinfected? Yes \_\_\_\_\_ No \_\_\_\_\_

TYPE OF BLANK CASING USED:		3 Wrought iron	8 Concrete tile	CASING JOINTS: <u>Glued</u>	Clamped
1 Steel	3 RMP (SR)	6 Asbestos-Cement	9 Other (specify below)	Welded	
<u>2</u> PVC	4 ABS	7 Fiberglass		Threaded	
Blank casing diameter	<u>8</u> in. to	ft., Dia	in. to	ft., Dia	in. to
Casing height above land surface	<u>4</u>	weight	<u>160</u>	lbs./ft. Wall thickness or gauge No.	
TYPE OF SCREEN OR PERFORATION MATERIAL:		<u>2</u> PVC	10 Asbestos-cement		
1 Steel	3 Stainless steel	5 Fiberglass	8 RMP (SR)	11 Other (specify)	
2 Brass	4 Galvanized steel	6 Concrete tile	9 ABS	12 None used (open hole)	
SCREEN OR PERFORATION OPENINGS ARE:		5 Gauzed wrapped	8 Saw cut	11 None (open hole)	
1 Continuous slot	<u>3</u> Mill slot	6 Wire wrapped	9 Drilled holes		
2 Louvered shutter	4 Key punched	7 Torch cut	10 Other (specify)		
SCREEN-PERFORATED INTERVALS:	From	<u>82</u>	ft. to	<u>42</u>	ft., From
	From		ft. to		ft., From
GRAVEL PACK INTERVALS:	From	<u>82</u>	ft. to	<u>25</u>	ft., From
	From		ft. to		ft., From

6 GROUT MATERIAL: 1 Neat cement 2 Cement grout 3 Bentonite 4 Other  
Grout Intervals: From 25 ft. to 3 ft., From ft. to ft., From ft. to ft.  
What is the nearest source of possible contamination:  
1 Septic tank 4 Lateral lines 7 Pit privy 10 Livestock pens 14 Abandoned water well  
2 Sewer lines 5 Cess pool 8 Sewage lagoon 11 Fuel storage 15 Oil well/Gas well  
3 Watertight sewer lines 6 Seepage pit 9 Feedyard 12 Fertilizer storage 16 Other (specify below)  
Direction from well? Spring Feed Creek  
How many feet? 50+

FROM	TO	LITHOLOGIC LOG	FROM	TO	PLUGGING INTERVALS
0	6	Earth			
6	9	gravel			
9	22	clay			
22	23	broken rock (surface water)			
23	45	red bed			
45	65	shale (gray) (water)			
65	82	shaly-lime			

7 CONTRACTOR'S OR LANDOWNER'S CERTIFICATION: This water well was (1) constructed, (2) reconstructed, or (3) plugged under my jurisdiction and was completed on (mo/day/year) 7/28/95 and this record is true to the best of my knowledge and belief. Kansas Water Well Contractor's License No. 493A This Water Well Record was completed on (mo/day/yr) 7/31/95 under the business name of Reserver Well Drilling by (signature) [Signature]