

CORRECTION(S) TO WATER WELL RECORD (WWC-5)

(to rectify lacking or incorrect information)

County: Butler

Location listed as:

Section-Township-Range: 8-T23S-4-5E

Fraction (  $\frac{1}{4}$   $\frac{1}{4}$   $\frac{1}{4}$ ): SW NE NE

Location changed to:

8-23S-4E

SW NE NE

Other changes: Initial statements: \_\_\_\_\_

Changed to: \_\_\_\_\_

Comments: \_\_\_\_\_


verification method: Written & legal descriptions, position on plat map,  
and mapping tool & aerial photos on KGS website.

initials: DRA date: 10/25/2006

1 LOCATION OF WATER WELL:	Fraction	Section Number	Township Number	Range Number
County: <b>BUTLER</b>	<b>SW NE NE 1/4</b>	<b>8 CLIFFORD</b>	<b>T 23-S</b>	<b>4-5 E</b> E/W

Distance and direction from nearest town or city street address of well if located within city?  
**170 NW AND RIVER VALLEY ROAD 1/2 WEST 1/4 SOUTH**

2 WATER WELL OWNER: <b>RICHARD B. MORRIS</b> <b>809 482</b>	Board of Agriculture, Division of Water Resources
RR #, St. Address, Box #: City, State, ZIP Code : <b>CANTON, KS 67428</b>	Application Number:

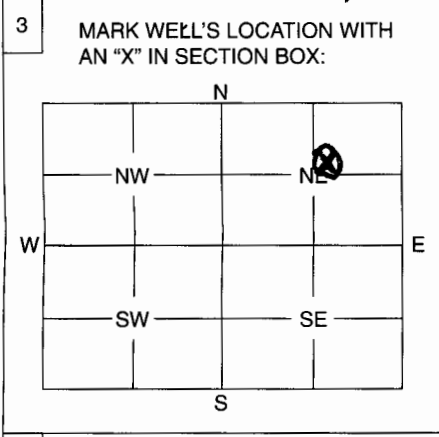

4 DEPTH OF WELL ..... <b>61</b> ..... ft.	WELL'S STATIC WATER LEVEL ..... <b>39</b> ..... ft.
WELL WAS USED AS:	
<input checked="" type="radio"/> 1 Domestic <input type="radio"/> 2 Irrigation <input type="radio"/> 3 Feedlot <input type="radio"/> 4 Industrial	<input type="radio"/> 5 Public Water Supply <input type="radio"/> 6 Oil Field Water Supply <input type="radio"/> 7 Domestic (Lawn & Garden) <input type="radio"/> 8 Air Conditioning
<input type="radio"/> 9 Dewatering <input type="radio"/> 10 Monitoring Well <input type="radio"/> 11 Injection Well <input type="radio"/> 12 Other .....	
Was a chemical / bacteriological sample submitted to Department? Yes ..... No <input checked="" type="checkbox"/> .....	
If yes, mo/day/yr sample was submitted .....	
Water Well Disinfected: Yes <input checked="" type="checkbox"/> No .....	

5 TYPE OF BLANK CASING USED:

1 Steel	3 RMP (SR)	5 Wrought	7 Fiberglass	9 Other (Specify below)
2 PVC	4 ABS	6 Asbestos-Cement	8 Concrete Tile	

Blank casing diameter ..... in. Was casing pulled? Yes ..... No ..... If yes, how much .....

Casing height above or below land surface ..... in.

6 GROUT PLUG MATERIAL: 1 Neat cement 2 Cement grout  3 Bentonite 4 Other .....

Grout Plug Intervals: From **61** ft. to **30** ft., From ..... ft. to ..... ft., From ..... to ..... ft.

What is the nearest source of possible contamination: **NONE**

1 Septic tank	6 Seepage pit	11 Fuel storage	16 Other (specify below)
2 Sewer lines	7 Pit privy	12 Fertilizer storage	
3 Watertight sewer lines	8 Sewage lagoon	13 Insecticide storage	
4 Lateral lines	9 Feedyard	14 Abandoned water well	
5 Cess pool	10 Livestock pens	15 Oil well/Gas well	

Direction from well? ..... How many feet? .....

FROM	TO	PLUGGING MATERIALS
<b>61'</b>	<b>30'</b>	<b>BENTONITE PLUG</b>
<b>30'</b>	<b>0'</b>	<b>CLAY TOP SOIL</b>

7 CONTRACTOR'S OF LANDOWNER'S CERTIFICATION: This water well was plugged under my jurisdiction and was completed on (mo/day/year) ... **10-05-06** ..... and this record is true to the best of my knowledge and belief. Kansas Water Well Contractor's License No. **699** This Water Well Record was completed on (mo/day/year) ..... under the business name of **FLINT HILLS WINDMILL AND PUMP SERVICE** by (signature) *[Signature]*

INSTRUCTIONS: Use typewriter or ball point pen. Please press firmly and print clearly. Please fill in blanks, underline or circle the correct answers. Send top three copies to Kansas Department of Health and Environment, Bureau of Water, Geology Section, 1000 SW Jackson St., Ste. 420, Topeka, Kansas 66612-1367. Telephone: 785/296-5522. Send one to Water Well Owner and retain one for your records.