

CORRECTION(S) TO WATER WELL RECORD (WWC-5)

(to rectify lacking or incorrect information)

County: Butler

Location listed as:

Location changed to:

Section-Township-Range: 8-23 S-4-5 E

8-23 S-4 E

Fraction ($\frac{1}{4}$ $\frac{1}{4}$ $\frac{1}{4}$): SW NE NE

SW NE NE

Other changes: Initial statements: _____

Changed to: _____

Comments: _____

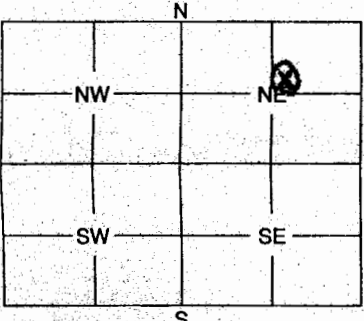
verification method: written & legal descriptions, area road map,
position on plat map, and mapping tool & aerial photos
on KGS website. initials: DRD date: 11/29/2006

submitted by: Kansas Geological Survey, Data Resources Library, 1930 Constant Ave., Lawrence, KS 66047-3726
to: Kansas Dept of Health & Environment, Bureau of Water, 1000 SW Jackson, Suite 420, Topeka, KS 66612-1367.

1 LOCATION OF WATER WELL: Fraction Section Number Township Number Range Number
 County: BUTLER SW 1/4 NE 1/4 NE 1/4 8 CLIFFORD T23-S 4-5 E EW

Distance and direction from nearest town or city street address of well if located within city?
 170 NW AND RIVER VALLEY ROAD 1/2 WEST 1/4 SOUTH

2 WATER WELL OWNER: RICHARD B. MORRIS
 RR #, St. Address, Box #: BOX 482
 City, State, ZIP Code: CANTON, KS 67428
 Board of Agriculture, Division of Water Resources Application Number:

3 MARK WELL'S LOCATION WITH AN "X" IN SECTION BOX:


4 DEPTH OF WELL 61 ft.
 WELL'S STATIC WATER LEVEL 39 ft.
 WELL WAS USED AS:
 1 Domestic 5 Public Water Supply 9 Dewatering
 2 Irrigation 6 Oil Field Water Supply 10 Monitoring Well
 3 Feedlot 7 Domestic (Lawn & Garden) 11 Injection Well
 4 Industrial 8 Air Conditioning 12 Other
 Was a chemical / bacteriological sample submitted to Department? Yes No X
 If yes, mo/day/yr sample was submitted
 Water Well Disinfected: Yes X No

5 TYPE OF BLANK CASING USED:
 1 Steel 3 RMP (SR) 5 Wrought 7 Fiberglass 9 Other (Specify below)
 2 PVC 4 ABS 6 Asbestos-Cement 8 Concrete Tile
 Blank casing diameter in. Was casing pulled? Yes No If yes, how much
 Casing height above or below land surface in.

6 GROUT PLUG MATERIAL: 1 Neat cement 2 Cement grout 3 Bentonite 4 Other
 Grout Plug Intervals: From 61 ft. to 30 ft. From to ft. From to ft.
 What is the nearest source of possible contamination: NONE
 1 Septic tank 6 Seepage pit 11 Fuel storage 16 Other (specify below)
 2 Sewer lines 7 Pit privy 12 Fertilizer storage
 3 Watertight sewer lines 8 Sewage lagoon 13 Insecticide storage
 4 Lateral lines 9 Feedyard 14 Abandoned water well
 5 Cess pool 10 Livestock pens 15 Oil well/Gas well
 Direction from well? How many feet?

FROM	TO	PLUGGING MATERIALS
61'	30'	BENTONITE PLUG
30'	0'	CLAY TOP SOIL

7 CONTRACTOR'S OF LANDOWNER'S CERTIFICATION: This water well was plugged under my jurisdiction and was completed on (mo/day/year) 10-05-06 and this record is true to the best of my knowledge and belief. Kansas Water Well Contractor's License No. 699 This Water Well Record was completed on (mo/day/year) under the business name of FLINT HILLS WINDMILL AND PUMP SERVICE by (signature) [Signature]

INSTRUCTIONS: Use typewriter or ball point pen. Please press firmly and print clearly. Please fill in blanks, underline or circle the correct answers. Send top three copies to Kansas Department of Health and Environment, Bureau of Water, Geology Section, 1000 SW Jackson St., Ste. 420, Topeka, Kansas 66612-1367. Telephone: 785/296-5522. Send one to Water Well Owner and retain one for your records.