


1	LOCATION OF WATER WELL:	Fraction	Section Number	Township Number	Range Number
	County: <u>Butler</u>	<u>1/4 1/4 1/4</u>	<u>35</u>	<u>23</u>	<u>4E</u>

Distance and direction from nearest town or city street address of well if located within city?
8 1/2 NE of Potwin, KS

2 WATER WELL OWNER: Joetta Swarey
 RR#, St. Address, Box #: 3520 NW 100th St
 City, State, ZIP Code: Burns, KS 66840

Board of Agriculture, Division of Water Resources
 Application Number:

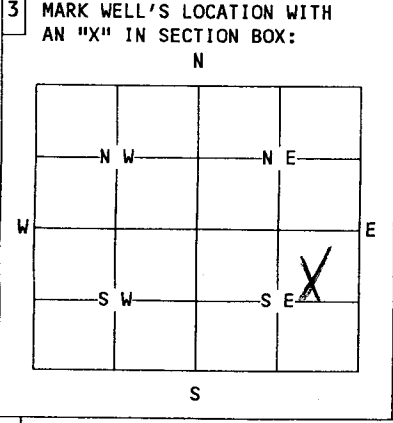

4 DEPTH OF WELL.....ft. 123'
 WELL'S STATIC WATER LEVEL.....ft. 70' to water
 WELL WAS USED AS: 53' of water

Domestic 5 Public Water Supply 9 Dewatering
 2 Irrigation 6 Oil Field Water Supply 10 Monitoring Well
 3 Feedlot 7 Lawn and Garden Only 11 Injection Well
 4 Industrial 8 Air Conditioning 12 Other.....

Was a chemical/bacteriological sample submitted to Department? Yes... No...
 If yes, mo/day/yr sample was submitted.....

Water Well Disinfected: Yes..... No.....

5 TYPE OF BLANK CASING USED:

1 Steel 3 RMP (SR) 5 Wrought 7 Fiberglass 9 Other (specify below)
 PVC 4 ABS 6 Asbestos-Cement 8 Concrete Tile

Blank casing diameter.....6.....in. Was casing pulled? Yes..... No..... If yes, how much.....
 Casing height above or below land surface.....in. Cut off 4' below ground.

6 GROUT PLUG MATERIAL: 1 Neat cement 2 Cement grout Bentonite 4 Other.....

Grout Plug Intervals: From.....ft. to.....ft., From.....ft. to.....ft., From..... to.....ft.
Put in sand for 53' then clay with Bentonite cap.

What is the nearest source of possible contamination:

1 Septic tank 6 Seepage pit 11 Fuel storage 16 Other (specify below)
 2 Sewer lines 7 Pit privy 12 Fertilizer storage
 3 Watertight sewer lines 8 Sewage lagoon 13 Insecticide storage
 4 Lateral lines Feedyard 14 Abandoned water well
 5 Cess Pool 10 Livestock pens 15 Oil well/Gas well

Direction from well? North..... How many feet? 1,300 ft.

FROM	TO	PLUGGING MATERIALS

well # 1 by garage

7 CONTRACTOR'S OR LANDOWNER'S CERTIFICATION: This water well was plugged under my jurisdiction and was completed on (mo/day/year) 11-23-07..... and this record is true to the best of my knowledge and belief. Kansas Water Well Contractor's License No. This Water Well Record was completed on (mo/day/year) 11-23-07..... under the business name of

by (signature) Joetta Swarey..... by Bevan Swarey.....

Kansas Dept. of Health & Environment
 Bureau of Water - Geology Section
 1000 SW Jackson Street, Suite 420
 Topeka KS 66612-1367

- 3 Copies to KDHE
- 1 Copy to Well Owner
- 1 Copy to Contractor