


1 LOCATION OF WATER WELL: Fraction SW 1/4 NE 1/4 NE 1/4 Section Number 26 Township Number T 23S Range Number R 4 E
 County: Butler
 Distance and direction from nearest town or city street address of well if located within city?

2 WATER WELL OWNER: McCormell AF13 (Titan Missile Site)
 RR#, St. Address, Box # : _____ Board of Agriculture, Division of Water Resources
 City, State, ZIP Code : Wichita, Kansas Application Number: _____

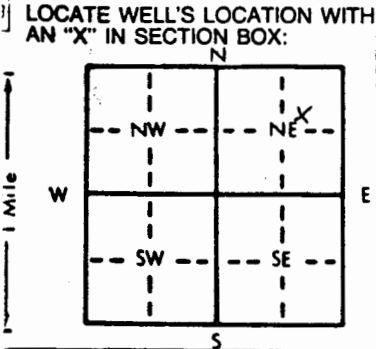

4 DEPTH OF COMPLETED WELL: 56.1 ft. ELEVATION: _____
 Depth(s) Groundwater Encountered 1. 48.0 ft. 2. _____ ft. 3. _____ ft.
 WELL'S STATIC WATER LEVEL 47.48 ft. below land surface measured on mo/day/yr 12/6/88
 Pump test data: Well water was None ft. after _____ hours pumping _____ gpm
 Est. Yield _____ gpm: Well water was _____ ft. after _____ hours pumping _____ gpm
 Bore Hole Diameter 11 in. to 56.1 ft., and _____ in. to _____ ft.
 WELL WATER TO BE USED AS:
 5 Public water supply 8 Air conditioning 11 Injection well
 1 Domestic 3 Feedlot 6 Oil field water supply 9 Dewatering 12 Other (Specify below)
 2 Irrigation 4 Industrial 7 Lawn and garden only 10 Monitoring well _____
 Was a chemical/bacteriological sample submitted to Department? Yes _____ No _____; If yes, mo/day/yr sample was submitted _____
 Water Well Disinfected? Yes _____ No _____

3 TYPE OF BLANK CASING USED:
 1 Steel 3 RMP (SR) 5 Wrought iron 8 Concrete tile CASING JOINTS: Glued _____ Clamped _____
2 PVC 4 ABS 6 Asbestos-Cement 9 Other (specify below) Welded _____
 7 Fiberglass Threaded _____
 Blank casing diameter 41.0 in. to _____ ft., Dia _____ in. to _____ ft., Dia _____ in. to _____ ft.
 Casing height above land surface 2.5 in., weight _____ lbs./ft. Wall thickness or gauge No. Sch. 40
 TYPE OF SCREEN OR PERFORATION MATERIAL:
 1 Steel 3 Stainless steel 5 Fiberglass 8 RMP (SR) 10 Asbestos-cement
 2 Brass 4 Galvanized steel 6 Concrete tile 9 ABS 11 Other (specify) _____
 12 None used (open hole)

SCREEN OR PERFORATION OPENINGS ARE:
 1 Continuous slot 3 Mill slot 5 Gauzed wrapped 8 Saw cut 11 None (open hole)
 2 Louvered shutter 4 Key punched 6 Wire wrapped 9 Drilled holes
 7 Torch cut 10 Other (specify) _____
 SCREEN-PERFORATED INTERVALS: From 41.0 ft. to 55.0 ft., From _____ ft. to _____ ft.
 From _____ ft. to _____ ft., From _____ ft. to _____ ft.
 GRAVEL PACK INTERVALS: From 37.3 ft. to 56.1 ft., From _____ ft. to _____ ft.
 From _____ ft. to _____ ft., From _____ ft. to _____ ft.

5 GROUT MATERIAL: 1 Neat cement 2 Cement grout 3 Bentonite 4 Other Bentonite/Bentonite
 Grout Intervals: From 9.5 ft. to 35.1 ft., From 35.1 ft. to 37.3 ft., From _____ ft. to _____ ft.
 What is the nearest source of possible contamination:
 1 Septic tank 4 Lateral lines 7 Pit privy 10 Livestock pens 14 Abandoned water well
 2 Sewer lines 5 Cess pool 8 Sewage lagoon 11 Fuel storage 15 Oil well/Gas well
 3 Watertight sewer lines 6 Seepage pit 9 Feedyard 12 Fertilizer storage 16 Other (specify below)
 13 Insecticide storage
 Direction from well? _____ How many feet? _____

FROM	TO	LITHOLOGIC LOG	FROM	TO	PLUGGING INTERVALS
0	3.0	Soil - DKBr CL			
3.0	4.0	Fill - Rock			
4.0	13.0	Clay - DKBr			
13.0	18.0	Limestone - Tan			
18.0	29.0	Clay - Br Br			
29.0	41.0	Limestone - Gr Br			

RECEIVED

RECEIVED

JUN 5 1989

OCT 27 1989

DIVISION OF ENVIRONMENT

DIVISION OF ENVIRONMENT

CONTRACTOR'S OR LANDOWNER'S CERTIFICATION: This water well was (1) constructed, (2) reconstructed, or (3) plugged under my jurisdiction and was completed on (mo/day/year) 10/13/88 and this record is true to the best of my knowledge and belief. Kansas Water Well Contractor's License No. 494 This Water Well Record was completed on (mo/day/yr) 10/13/88 under the business name of Southwestern Geotech Inc by (signature) [Signature]