


1 LOCATION OF WATER WELL: Fraction SW 1/4 NE 1/4 NE 1/4 Section Number 26 Township Number T 23 S Range Number R 4 E
 County: Butler
 Distance and direction from nearest town or city street address of well if located within city?

2 WATER WELL OWNER: RR#, St. Address, Box #: Board of Agriculture, Division of Water Resources
 City, State, ZIP Code: Application Number:

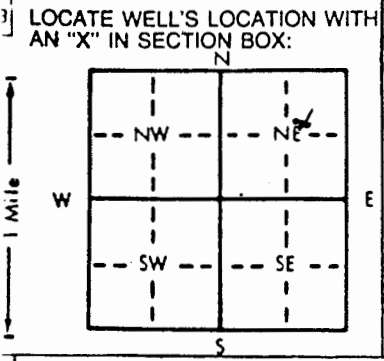

4 DEPTH OF COMPLETED WELL: 44.1 ft. ELEVATION: ...
 Depth(s) Groundwater Encountered 1. 40.0 ft. 2. ... ft. 3. ... ft.
 WELL'S STATIC WATER LEVEL: 39.92 ft. below land surface measured on mo/day/yr 12/16/88
 Pump test data: Well water was ... ft. after ... hours pumping ... gpm
 Est. Yield ... gpm: Well water was ... ft. after ... hours pumping ... gpm
 Bore Hole Diameter ... in. to ... ft., and ... in. to ... ft.
 WELL WATER TO BE USED AS:
 5 Public water supply 8 Air conditioning 11 Injection well
 1 Domestic 3 Feedlot 6 Oil field water supply 9 Dewatering 12 Other (Specify below)
 2 Irrigation 4 Industrial 7 Lawn and garden only 10 Monitoring well
 Was a chemical/bacteriological sample submitted to Department? Yes ... No ; If yes, mo/day/yr sample was submitted
 Water Well Disinfected? Yes ... No

5 TYPE OF BLANK CASING USED:
 1 Steel 3 RMP (SR) 5 Wrought iron 8 Concrete tile CASING JOINTS: Glued ... Clamped ...
 2 PVC 4 ABS 6 Asbestos-Cement 9 Other (specify below) Welded ...
 7 Fiberglass ... Threaded ...
 Blank casing diameter 2 in. to 34.1 ft., Dia ... in. to ... ft., Dia ... in. to ... ft.
 Casing height above land surface 2.0 in., weight ... lbs./ft. Wall thickness or gauge No. Sch 40

TYPE OF SCREEN OR PERFORATION MATERIAL:
 1 Steel 3 Stainless steel 5 Fiberglass 8 RMP (SR) 10 Asbestos-cement
 2 Brass 4 Galvanized steel 6 Concrete tile 9 ABS 11 Other (specify) ...
 12 None used (open hole)
 SCREEN OR PERFORATION OPENINGS ARE:
 1 Continuous slot 3 Mill slot 5 Gauzed wrapped 8 Saw cut 11 None (open hole)
 2 Louvered shutter 4 Key punched 6 Wire wrapped 9 Drilled holes
 7 Torch cut 10 Other (specify) ...

SCREEN-PERFORATED INTERVALS: From 34.1 ft. to 43.1 ft., From ... ft. to ... ft.
 GRAVEL PACK INTERVALS: From 30.4 ft. to 44.1 ft., From ... ft. to ... ft.

6 GROUT MATERIAL: 1 Neat cement 2 Cement grout 3 Bentonite 4 Other Cement/Bentonite
 Grout Intervals: From 2.0 ft. to 28.0 ft., From 28.0 ft. to 30.4 ft., From ... ft. to ... ft.
 What is the nearest source of possible contamination:
 1 Septic tank 4 Lateral lines 7 Pit privy 10 Livestock pens 14 Abandoned water well
 2 Sewer lines 5 Cess pool 8 Sewage lagoon 11 Fuel storage 15 Oil well/Gas well
 3 Watertight sewer lines 6 Seepage pit 9 Feedyard 12 Fertilizer storage 16 Other (specify below)
 13 Insecticide storage 14. Unknown


Direction from well? How many feet?

FROM	TO	LITHOLOGIC LOG	FROM	TO	PLUGGING INTERVALS
0	1.0	Soil - Generally			
1.0	19.5	Clay - Gr Si			
19.5	35.0	Limestone - Gr Cl Dry			
35.0	43.0	" " " Saturated			
43.0	45.0	Shale Gr Cl Dry			



RECEIVED
 RECEIVED
 RECEIVED
 OCT 27 1989
 JUN 15 1989
 DIVISION OF ENVIRONMENT
 DIVISION OF ENVIRONMENT


CONTRACTOR'S OR LANDOWNER'S CERTIFICATION: This water well was (1) constructed, (2) reconstructed, or (3) plugged under my jurisdiction and was completed on (mo/day/year) 12/12/88 and this record is true to the best of my knowledge and belief. Kansas Water Well Contractor's License No. 494 This Water Well Record was completed on (mo/day/yr) 12/29/89 under the business name of Southwest Water Inc by (signature) Robert L. D...

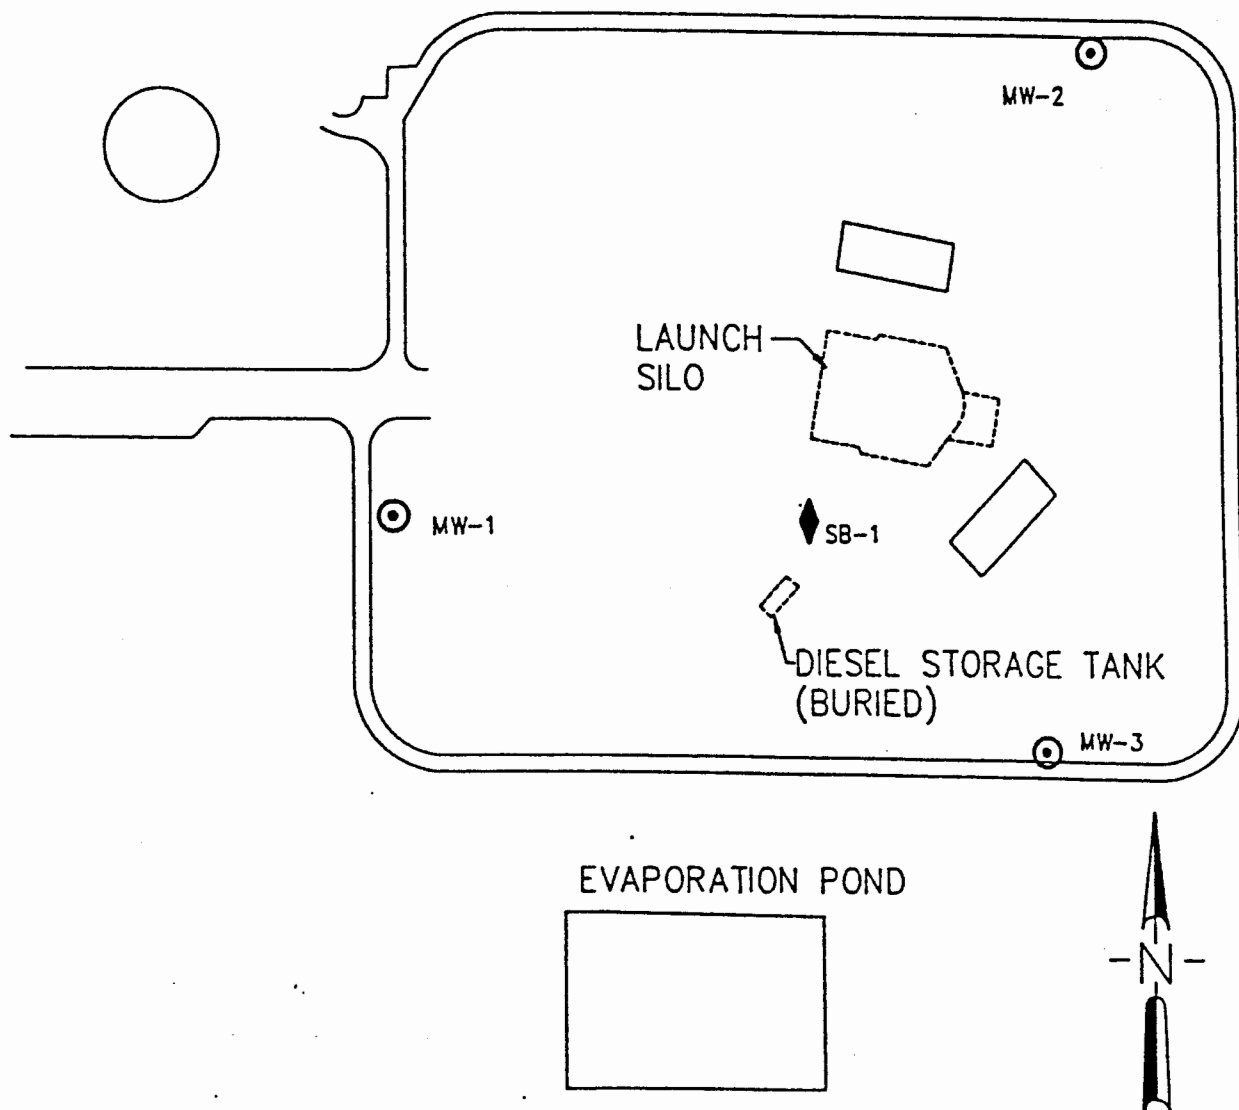MISSILE SITE 533-2 SPILL SITE NO. 1



LEGEND

- MW-1  PROPOSED MONITORING WELL LOCATION
- SB-1  PROPOSED SOIL BORING LOCATION

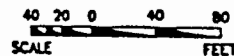

Source document:
McConnell AFB
Missile Site 533-2
Removal Plan
July 1984