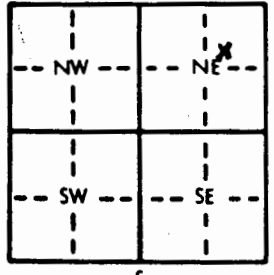


1 LOCATION OF WATER WELL: Fraction SW 1/4 NE 1/4 NE 1/4 Section Number 26 Township Number T 23 S Range Number R 4 E
 County: Butler
 Distance and direction from nearest town or city street address of well if located within city?

2 WATER WELL OWNER: McConnell AFB (Titan Missile Site)
 RR#, St. Address, Box #: _____ Board of Agriculture, Division of Water Resources
 City, State, ZIP Code: Wichita, Kansas Application Number: _____

3 LOCATE WELL'S LOCATION WITH AN "X" IN SECTION BOX:

 4 DEPTH OF COMPLETED WELL: 59.5 ft. ELEVATION: _____
 Depth(s) Groundwater Encountered 1. 48.0 ft. 2. _____ ft. 3. _____ ft.
 WELL'S STATIC WATER LEVEL: 17.62 ft. below land surface measured on 12/6/88
 Pump test data: Well water was None ft. after _____ hours pumping _____ gpm
 Est. Yield _____ gpm: Well water was _____ ft. after _____ hours pumping _____ gpm
 Bore Hole Diameter: 1.1 in. to 39.5 in., and _____ in. to _____ ft.
 WELL WATER TO BE USED AS:
 5 Public water supply 8 Air conditioning 11 Injection well
 1 Domestic 3 Feedlot 6 Oil field water supply 9 Dewatering 12 Other (Specify below)
 2 Irrigation 4 Industrial 7 Lawn and garden only 10 Monitoring well
 Was a chemical/bacteriological sample submitted to Department? Yes _____ No ; If yes, mo/day/yr sample was submitted _____
 Water Well Disinfected? Yes _____ No

5 TYPE OF BLANK CASING USED:
 1 Steel 3 RMP (SR) 5 Wrought iron 8 Concrete tile CASING JOINTS: Glued _____ Clamped _____
2 PVC 4 ABS 6 Asbestos-Cement 9 Other (specify below) Welded _____
 7 Fiberglass Threaded
 Blank casing diameter: 2 in. to 44.5 ft., Dia. _____ in. to _____ ft., Dia. _____ in. to _____ ft.
 Casing height above land surface: 3.1 in., weight _____ lbs./ft. Wall thickness or gauge No. 5240

TYPE OF SCREEN OR PERFORATION MATERIAL:
 1 Steel 3 Stainless steel 5 Fiberglass 7 PVC 10 Asbestos-cement
 2 Brass 4 Galvanized steel 6 Concrete tile 8 RMP (SR) 11 Other (specify) _____
 9 ABS 12 None used (open hole)

SCREEN OR PERFORATION OPENINGS ARE:
 1 Continuous slot 3 Mill slot 5 Gauzed wrapped 8 Saw cut 11 None (open hole)
 2 Louvered shutter 4 Key punched 6 Wire wrapped 9 Drilled holes
 7 Torch cut 10 Other (specify) _____

SCREEN-PERFORATED INTERVALS: From 44.5 ft. to 38.5 ft., From _____ ft. to _____ ft.
 From _____ ft. to _____ ft., From _____ ft. to _____ ft.

GRAVEL PACK INTERVALS: From 40.9 ft. to 39.5 ft., From _____ ft. to _____ ft.
 From _____ ft. to _____ ft., From _____ ft. to _____ ft.

6 GROUT MATERIAL: 1 Neat cement 2 Cement grout Bentonite 4 Other Cement/Bentonite
 Grout Intervals: From 2.0 ft. to 38.7 ft., From 38.7 ft. to 40.9 ft., From _____ ft. to _____ ft.

What is the nearest source of possible contamination:
 1 Septic tank 4 Lateral lines 7 Pit privy 10 Livestock pens 14 Abandoned water well
 2 Sewer lines 5 Cess pool 8 Sewage lagoon 11 Fuel storage 15 Oil well/Gas well
 3 Watertight sewer lines 6 Seepage pit 9 Feedyard 12 Fertilizer storage 16 Other (specify below)
 13 Insecticide storage


Direction from well? _____ How many feet? _____

FROM	TO	LITHOLOGIC LOG	FROM	TO	PLUGGING INTERVALS
0	1.0	Soil - Gravel			
1.0	5.7	Clay - Br w/ gravel			
5.7	6.8	limestone - Tan			
6.8	17.0	Clay - Lt yellow Si			
17.0	19.5	limestone - Tan w/ CL			
19.5	29.5	Clay - Tan Si			
29.5	31.5	Silt - Tan CL			
31.5	44.5	Limestone - Tan CL			
44.5	45.5	Silt - Tan CL			
45.5	59.5	Limestone - Tan CL			

RECEIVED
 JUN 15 1989
 DIVISION OF ENVIRONMENT
 OCT 27 1989
 DIVISION OF ENVIRONMENT

CONTRACTOR'S OR LANDOWNER'S CERTIFICATION: This water well was (1) constructed, (2) reconstructed, or (3) plugged under my jurisdiction and was completed on (mo/day/year) 10/12/88 and this record is true to the best of my knowledge and belief. Kansas Water Well Contractor's License No. 494 This Water Well Record was completed on (mo/day/yr) 1/30/89
 under the business name of Southwestern Water Inc by (signature) _____

LANDFILL NO.2

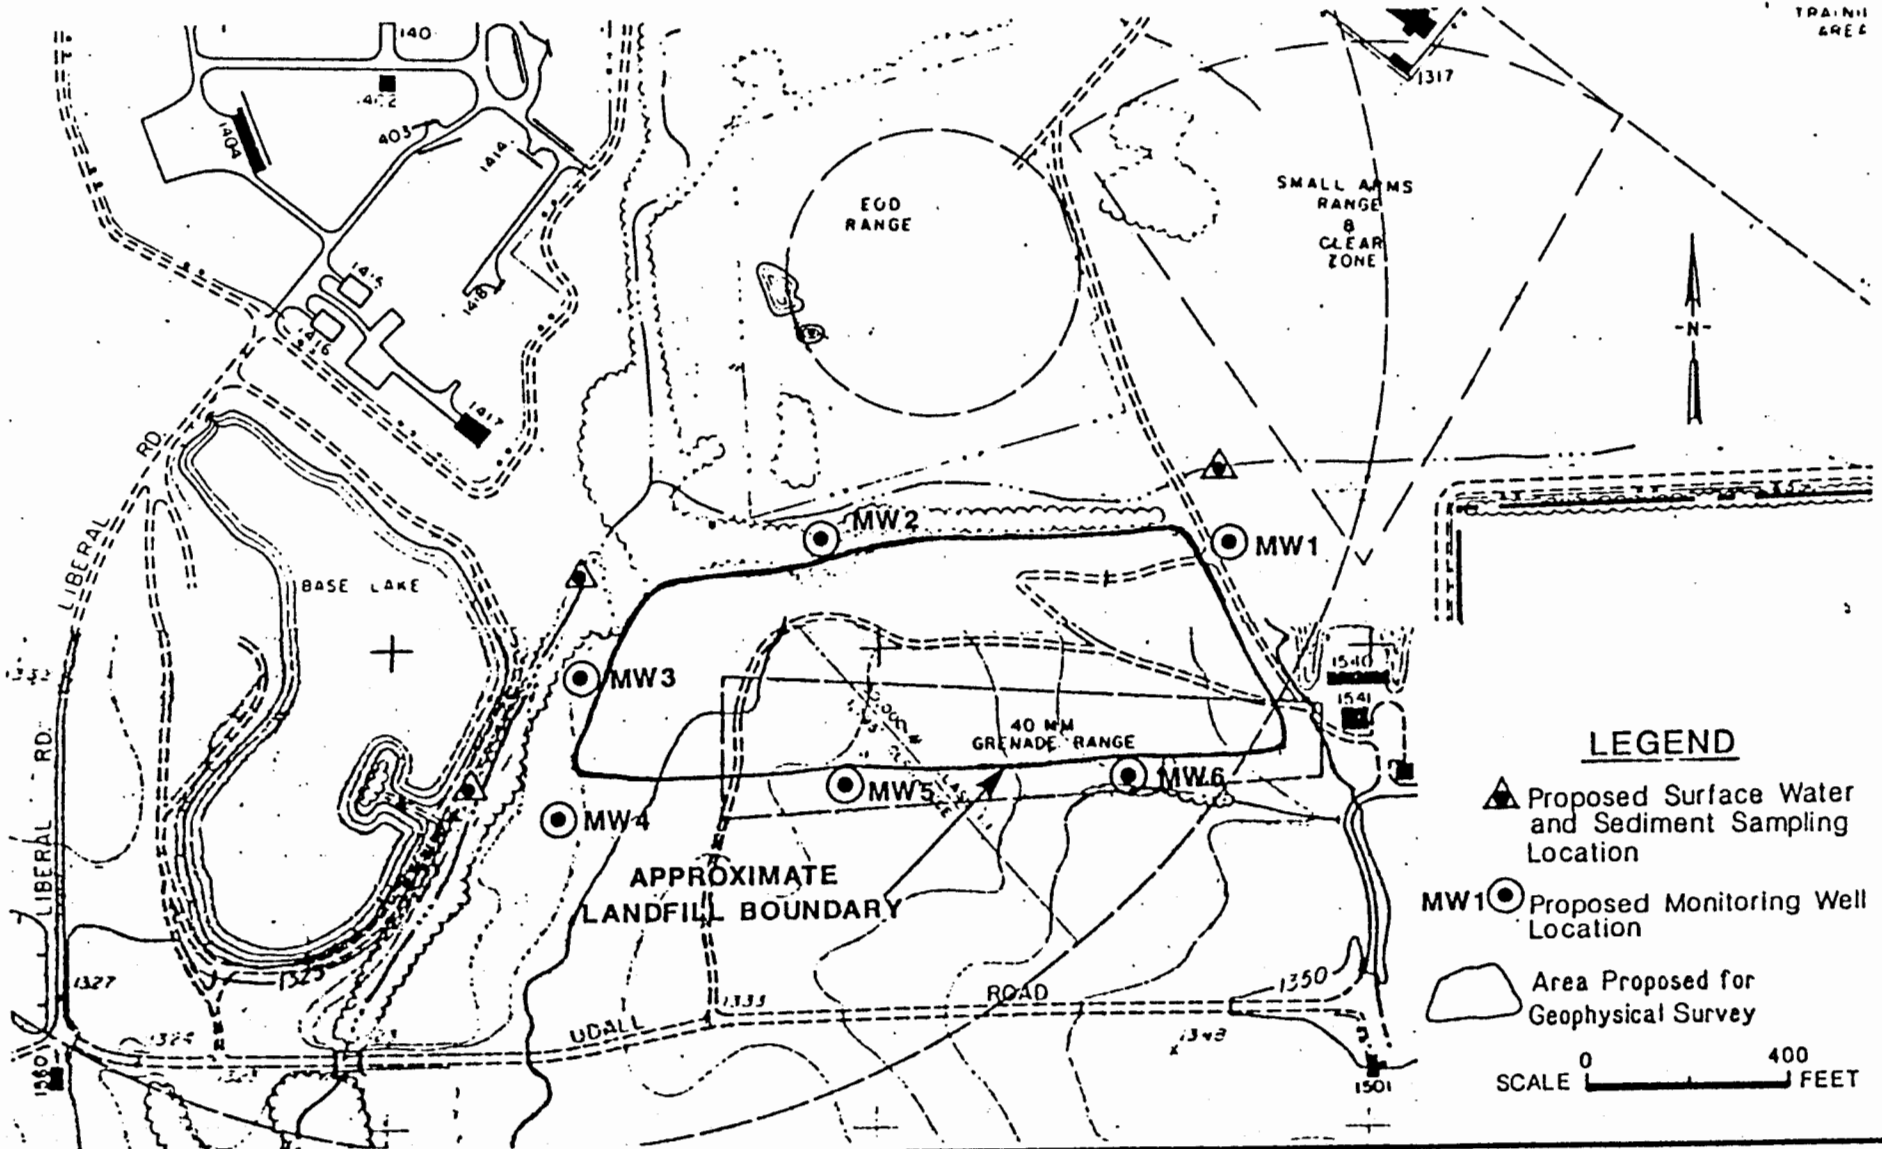

LEGEND

- ▲ Proposed Surface Water and Sediment Sampling Location
- MW1 ● Proposed Monitoring Well Location
- ▭ Area Proposed for Geophysical Survey

SCALE 0 400 FEET