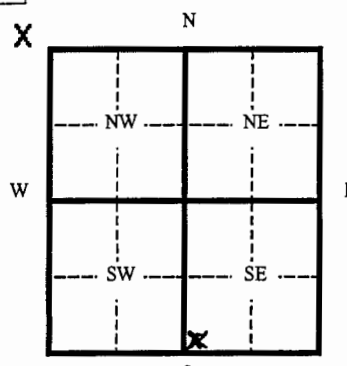


ID No. Well #6

1 LOCATION OF WATER WELL:		Fraction	Section Number	Township Number	Range Number
County: Ellis		SW 1/4 SW 1/4 SE 1/4	#5	13 S	20 W
Distance and direction from nearest town or city street address of well if located within city? West of 6th and Taylor					
2 WATER WELL OWNER: City of Ellis			Board of Agriculture, Division of Water Resources		
RR#, St. Address, Box # 815 Jefferson			Application Number:		
City, State, ZIP Code : Ellis, Kansas 67637					
3 MARK WELL'S LOCATION WITH AN "X" IN SECTION BOX:		4 DEPTH OF WELL 45 ft.			
		WELL'S STATIC WATER LEVEL 12 ft.			
		WELL WAS USED AS:			
		1 Domestic 5 Public Water Supply 9 Dewatering			
		2 Irrigation 6 Oil Field Water Supply 10 Monitoring Well			
		3 Feedlot 7 Lawn and Garden (domestic) 11 Injection Well			
		4 Industrial 8 Air Conditioning 12 Other			
		Was a chemical/bacteriological sample submitted to Department? Yes No XX			
		If yes, mo/day/yr sample was submitted			
		Water Well Disinfected: Yes XX No			
5 TYPE OF BLANK CASING USED:					
1 Steel 3 RMP (SR) 5 Wrought 7 Fiberglass 9 Other (specify below)					
2 PVC 4 ABC 6 Asbestos-Cement 8 Concrete Tile					
Blank casing diameter 12 in. Was casing pulled? Yes No XX If yes, how much					
Casing height above or below land surface 36 in.					
6 GROUT PLUG MATERIAL: 1 Neat cement 2 Cement grout 3 Bentonite 4 Other					
Grout Plug Intervals From ft. to ft. From ft. to ft. From ft. to ft.					
What is the nearest source of possible contamination:					
1 Septic tank 6 Seepage pit 11 Fuel storage 16 Other (specify below)					
2 Sewer lines 7 Pit privy 12 Fertilizer storage None Known					
3 Watertight sewer lines 8 Sewage lagoon 13 Insecticide storage					
4 Lateral lines 9 Feedyard 14 Abandoned water well					
5 Cess Pool 10 Livestock pens 15 Oil well/ Gas well					
Direction from well? How many feet?					
FROM	TO	CODE	PLUGGING MATERIALS		
45	25		Chlorinated Sand		
25	3'		Cement Grout		
3'	0'		Topsoil		
7 CONTRACTOR'S OR LANDOWNER'S CERTIFICATION: This water well was plugged under my jurisdiction and was completed on (mo/day/yr) December 15th 2008 and this record is true to the best of my knowledge and belief. Kansas Water Well Contractor's License No. 102 This Water Well Record was completed on (mo/day/yr) under the business name of Layne Christensen Company by (signature) Russell W. Christensen					
INSTRUCTIONS: Please fill in blanks and circle the correct answers. Send three copies to Kansas Department of Health and Environment, Bureau of Water, 1000 S W Jackson St., Ste. 420, Topeka, Kansas 66620-0001. Telephone: 785-296-3565. Send one to Water Well Owner and retain one for your records.					