

SE 1/4 23:5


USE TYPEWRITER OR BALL POINT PEN-PRESS FIRMLY, PRINT CLEARLY.

WATER WELL RECORD
KSA 82a-1201-1215

Kansas Department of Health and Environment-Division of Environment
(Water well Contractors)
Topeka, Kansas 66620

1. Location of well: County Butler Fraction NE 1/4 NE 1/4 SE 1/4 Section number R.F. 4 Township number 23 Range number 5

2. Distance and direction from nearest town or city: 3/4 ml. S. E. 3. Owner of well: Vincent Vesting
Street address of well location if in city: Burns R.R. or street: Rt 1
City, state, zip code: Burns, KS 66405

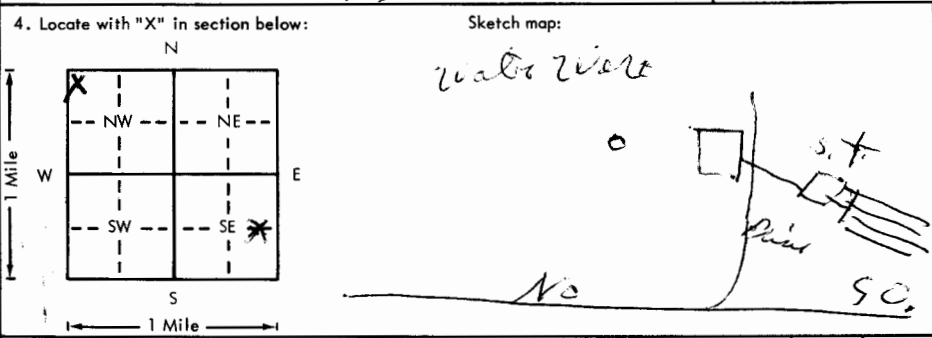

6. Bore hole dia. 10 in. Completion date 9-27-77
Well depth 75 ft.

7. Cable tool Rotary Driven Dug
 Hollow rod Jetted Bored Reverse rotary

8. Use: Domestic Public supply Industry
 Irrigation Air conditioning Stock
 Lawn Oil field water Other

9. Casing: Material Iron Height: Above or below
Threaded Welded Surface 23 in.
RMP PVC Weight 40 lbs./ft.
Dia. 5 in. to ft. depth Wall Thickness 19.5 inches or
Dia. in. to ft. depth gage No. 4025E

5. Type and color of material	From	To
Top Soil	0	3
Red Clay	3	15
Limestone	15	65
Red Clay or Red Linc	65	75
Limestone	75	

10. Screen: Manufacturer's name M.P.I.
Type P.P.C. Dia. 6"
Slot/gauze 25/1000 Length 19'
Set between 65 ft. and 75 ft.

Gravel pack? Size range of material 5/8

11. Static water level: 30 ft. below land surface Date 9-27-77 mo./day/yr.

12. Pumping level below land surfaces:
____ ft. after ____ hrs. pumping ____ g.p.m.
____ ft. after ____ hrs. pumping ____ g.p.m.
Estimated maximum yield 40 g.p.m.

13. Water sample submitted: ____ mo./day/yr.
Yes No Date ____

14. Well head completion:
____ Pitless adapter ____ Inches above grade

15. Well grouted?
With: Neat cement Bentonite Concrete
Depth: From 0 ft. to 10 ft.

16. Nearest source of possible contamination: Apple Valley
ft. 800 Direction NO Type Apple Valley
Well disinfected upon completion? Yes No

17. Pump: Not installed
Manufacturer's name ____ HP ____ Volts ____
Model number ____ Length of drop pipe ____ ft. capacity ____ g.p.m.
Type: Submersible Turbine
 Jet Reciprocating
 Centrifugal Other

18. Elevation: Topography: Hill Slope Upland Valley
19. Remarks: (Use a second sheet if needed)
20. Water well contractor's certification:
This well was drilled under my jurisdiction and this report is true to the best of my knowledge and belief.
Mawit east Co. 353
Business name License No. Box 744 Eldorado
Address Burns, KS
Signed Derek P. Pruitt Date 9-27-77
Authorized representative

T 23
R 5
W 4
Sec 4
1/4 1/4 1/4