

USE TYPEWRITER OR BALL POINT PEN-PRESS FIRMLY, PRINT CLEARLY.


T R EW sec 1/4 1/4 1/4 No.

WATER WELL RECORD
KSA 82a-1201-1215

Kansas State Dept. Of Health
(Water Well Contractors)
Forbes-Bldg. 740
Topeka, Kansas 66620

1 Location of well: County Butler Township name Lincoln Fraction NW 1/4 NE 1/4 Section number 110 Town number 23 Range number 5

2 Distance and direction from nearest town or city: 2 so. Burns 3 Owner of well: Alvine Koehn
Street address of well location if in city: Burns 66480 Address:

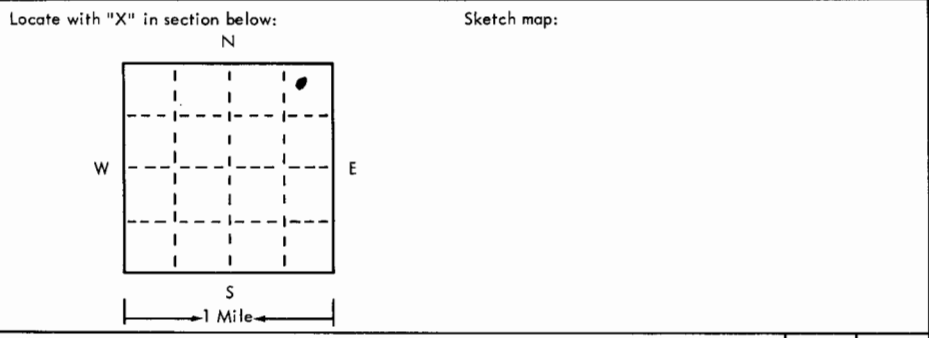

4 Well depth: 92 ft. Date of completion May 9 1976
Well diameter 9 in.
5 Cable tool Rotary Driven Dug
 Hollow rod Jetted Bored Reverse rotary
6 Use: Domestic Public supply Industry
 Irrigation Air conditioning Commercial
 Test well
7 Casing: Material plu Height: above/below
Threaded Welded Surface in.
Diam. 6 in. Weight lbs./ft.
92 ft. depth Drive shoe? Yes No
 in. to ft. depth Sec 80

2	Type and color of material	From	To
	<u>Chumbo</u>		<u>3</u>
	<u>Gyne</u>	<u>20</u>	<u>23</u>
	<u>Shale</u>	<u>7</u>	<u>30</u>
	<u>Bed Rock</u>	<u>20</u>	<u>50</u>
	<u>Shale</u>	<u>5</u>	<u>55</u>
	<u>Gyne</u>	<u>10</u>	<u>65</u>
	<u>Shale</u>	<u>5</u>	<u>70</u>
	<u>Gyne</u> → <u>Water 25 gpm in</u>	<u>20</u>	<u>90</u>
	<u>Shale</u>	<u>2</u>	<u>92</u>

8 Screen: Manufacturer MHC
Type plst Dia. 6"
Slot/gauze 3/32 Length 620'
Set between 20' and 72'-92'
Fittings:
Gravel pack Yes No Size range of material
9 Static water level: MHC 5-9-76
70 ft. below land surface Date
10 Pumping level below land surfaces:
 ft. after hrs. pumping g.p.m.
 ft. after hrs. pumping g.p.m.
Estimated maximum yield g.p.m.
11 Water sample submitted:
 Yes No Date
12 Well head completion:
 Pitless adapter 16 inches above grade
13 Well grouted? Yes No
 Neat cement Bentonite
Depth: 20' ft. 20'
14 Nearest source of possible contamination: MHC
ft. 100 Direction N Type Septic
Well disinfected upon completion? Yes No
15 Pump: Not installed
Manufacturer's name
Model number HP Volts
Length of drop pipe ft. capacity g.m.p.
Type:
 Submersible Turbine
 Jet Reciprocating
 Centrifugal Other

16 Remarks: elevation

Topography:
 Hill
 Slope
 Upland
 Valley

17 Water well contractor's certification:
This well was drilled under my jurisdiction and this report is true to the best of my knowledge and belief.
Spring Water Well 2
Business name Marion Kp License No.
Address
Signed William Schimpf Date
Authorized representative

23 T 5E 10 S NW 1/4 NE