


USE TYPEWRITER OR BALL POINT PEN-PRESS FIRMLY, PRINT CLEARLY.

WATER WELL RECORD
KSA 82a-1201-1215

Kansas State Dept. Of Health
(Water Well Contractors)
Forbes-Bldg. 740
Topeka, Kansas 66620

1 Location of well: County Butler Township name Genover Fraction SWNW Section number 16 Town number 23 Range number 5

Distance and direction from nearest town or city: Burns 3 Owner of well: Burns Kansas
Street address of well location if in city: 2 1/2 S W Burns Address: Herman Bach 66840

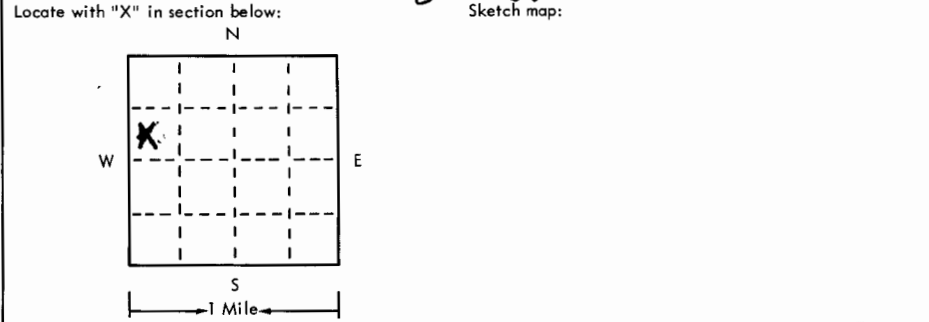

4 Well depth: 90 ft. Date of completion Aug 27
Well diameter 9 in.

5 Cable tool Rotary Driven Dug
 Hollow rod Jetted Bored Reverse rotary

6 Use: Domestic Public supply Industry
 Irrigation Air conditioning Commercial
 Test well

7 Casing: Material MC Height: above/below
Threaded Welded Surface 76 in. MC
Diam. 6 in. to 90 ft. depth Weight 4.8
Drive shoe? Yes No

2	Type and color of material	From	To
	<u>Grumbo</u>		<u>8</u>
	<u>Gyire</u>	<u>5</u>	<u>13</u>
	<u>Shale</u>	<u>10</u>	<u>23</u>
	<u>Time</u>	<u>12</u>	<u>35</u>
	<u>Soap stone</u>	<u>20</u>	<u>58</u>
	<u>Red Rock</u>	<u>15</u>	<u>70</u>
	<u>Time</u> → <u>Water 25 gal min</u>	<u>20</u>	<u>90</u>

8 Screen:
Manufacturer _____
Type Plus Dia. 6 in
Slot/gauze _____ Length _____
Set between 70 ft. and 90 ft.
Fittings:
Gravel pack Yes No Size range of material _____

9 Static water level:
52 ft. below land surface Date 8-2-76

10 Pumping level below land surfaces:
_____ ft. after _____ hrs. pumping _____ g.p.m.
_____ ft. after _____ hrs. pumping _____ g.p.m.
Estimated maximum yield _____ g.p.m.

11 Water sample submitted:
 Yes No Date _____

12 Well head completion:
 Pitless adapter 16 inches above grade

13 Well grouted? Yes No
 Neat cement Bentonite
Depth: From 80 ft. to 90 top 15 ft.

14 Nearest source of possible contamination:
ft. 1000 Direction _____ Type _____
Well disinfected upon completion? Yes No

15 Pump: Not installed
Manufacturer's name _____
Model number _____ HP _____ Volts _____
Length of drop pipe _____ ft. capacity _____ g.m.p.
Type:
 Submersible Turbine
 Jet Reciprocating
 Centrifugal Other

16 Remarks: elevation

Topography:
 Hill
 Slope
 Upland
 Valley

17 Water well contractor's certification:
This well was drilled under my jurisdiction and this report is true to the best of my knowledge and belief.
Johnnie Waterwell
Business name _____ License No. _____
Address Burns 278
Signed [Signature] Date Aug 27
Authorized representative

23 SW 16 S WNW