


1 LOCATION OF WATER WELL: Fraction NW 1/4 NE 1/4 NW 1/4 Section Number 30 Township Number T 23 S Range Number R 7 **3W**  
 County: **Butler**

Distance and direction from nearest town or city street address of well if located within city?  
**4W 1/2 Cassidy**

2 WATER WELL OWNER: **Larry Berges**  
 RR#, St. Address, Box #: **RR 1 Box 46**  
 City, State, ZIP Code: **Cassoday, Mo 66842**  
 Board of Agriculture, Division of Water Resources  
 Application Number:

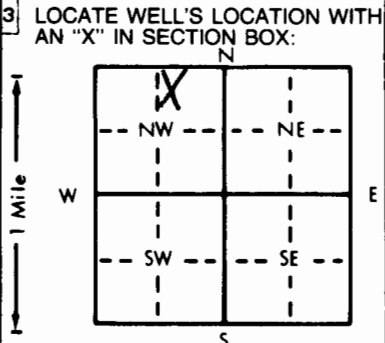

4 DEPTH OF COMPLETED WELL: **80** ft. ELEVATION:  
 Depth(s) Groundwater Encountered 1. **70** ft. 2. ft. 3. ft.  
 WELL'S STATIC WATER LEVEL **55** ft. below land surface measured on mo/day/yr **3/2/95**  
 Pump test data: Well water was ft. after hours pumping gpm  
 Est. Yield **35** gpm: Well water was ft. after hours pumping gpm  
 Bore Hole Diameter **10** in. to **80** ft., and in. to ft.  
 WELL WATER TO BE USED AS:  
 Domestic 3 Feedlot 6 Oil field water supply 9 Dewatering 12 Other (Specify below)  
 2 Irrigation 4 Industrial 7 Lawn and garden only 10 Monitoring well  
 Was a chemical/bacteriological sample submitted to Department? Yes No  X; If yes, mo/day/yr sample was submitted  
 Water Well Disinfected? Yes  No  No

5 TYPE OF BLANK CASING USED:  
 1 Steel 3 RMP (SR) 5 Wrought iron 8 Concrete tile CASING JOINTS: Glued  X Clamped  
 2 PVC 4 ABS 6 Asbestos-Cement 9 Other (specify below) Welded  
 7 Fiberglass Threaded  
 Blank casing diameter **6.5** in. to **60** ft., Dia in. to ft., Dia in. to ft.  
 Casing height above land surface **12** in., weight lbs./ft. Wall thickness or gauge No. **540**  
 TYPE OF SCREEN OR PERFORATION MATERIAL:  
 1 Steel 3 Stainless steel 5 Fiberglass 8 RMP (SR) 10 Asbestos-cement  
 2 Brass 4 Galvanized steel 6 Concrete tile 9 ABS 11 Other (specify)  
 12 None used (open hole)  
 SCREEN OR PERFORATION OPENINGS ARE:  
 1 Continuous slot  3 Mill slot 5 Gauzed wrapped 8 Saw cut 11 None (open hole)  
 2 Louvered shutter 4 Key punched 6 Wire wrapped 9 Drilled holes  
 7 Torch cut 10 Other (specify)  
 SCREEN-PERFORATED INTERVALS: From **60** ft. to **80** ft., From ft. to ft.  
 From ft. to ft., From ft. to ft.  
 GRAVEL PACK INTERVALS: From **20** ft. to **80** ft., From ft. to ft.  
 From ft. to ft., From ft. to ft.

6 GROUT MATERIAL: 1 Neat cement 2 Cement grout  3 Bentonite 4 Other  
 Grout intervals: From **3** ft. to **20** ft., From ft. to ft., From ft. to ft.  
 What is the nearest source of possible contamination:  
 1 Septic tank  4 Lateral lines  7 Pit privy  10 Livestock pens  14 Abandoned water well  
 2 Sewer lines  5 Cess pool  8 Sewage lagoon  11 Fuel storage  15 Oil well/Gas well  
 3 Watertight sewer lines  6 Seepage pit  9 Feedyard  12 Fertilizer storage  16 Other (specify below)  
 13 Insecticide storage **Creek**  
 Direction from well? **West** How many feet? **150'**

FROM	TO	LITHOLOGIC LOG	FROM	TO	PLUGGING INTERVALS
0	6	dirt			
6	20	gumbo			
20	45	yellow clay			
45	70	shale			
70	80	shale - lime			

7 CONTRACTOR'S OR LANDOWNER'S CERTIFICATION: This water well was (1) constructed, (2) reconstructed, or (3) plugged under my jurisdiction and was completed on (mo/day/year) **3/2/95** and this record is true to the best of my knowledge and belief. Kansas Water Well Contractor's License No. **493** This Water Well Record was completed on (mo/day/yr) **8/5/95** under the business name of **Reiserer Well Drilling** by (signature) *Oliver Reiserer*