


USE TYPEWRITER OR BALL POINT PEN. PRESS FIRMLY. PRINT CLEARLY.

WATER WELL RECORD
KSA 82a-1201-1215

Kansas Department of Health and Environment-Division of Environment
(Water well Contractors)
Topeka, Kansas 66620

1. Location of well: County Butter Fraction SE 1/4 SE 1/4 SE 1/4 Section number 10 Township number T 23 S R 7 Range number E/W

2. Distance and direction from nearest town or city: Street address of well location if in city: Cassoday
3. Owner of well: Henry Oldfield
R.R. or street: RR1 City, state, zip code: Cassoday Kansas

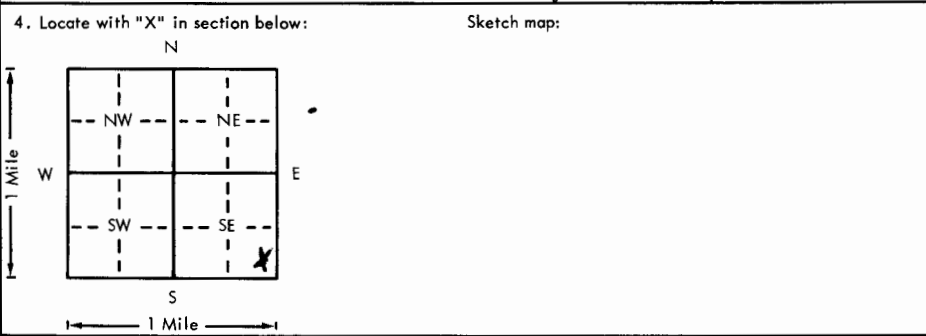

6. Bore hole dia. 18 in. Completion date 1-22-97
Well depth 100 ft.
7. Cable tool Rotary Driven Dug
 Hollow rod Jetted Bored Reverse rotary
8. Use: Domestic Public supply Industry
 Irrigation Air conditioning Stock
 Lawn Oil field water Other
9. Casing: Material _____ Height: Above or below
Threaded _____ Welded _____ Surface _____ in.
RMP _____ PVC _____ Weight _____ lbs./ft.
Dia. _____ in. to _____ ft. depth Wall Thickness: inches or
Dia. _____ in. to _____ ft. depth gage No. _____

5. Type and color of material

	From	To
Top Soil	0	5
Shale	5	10
Shale	10	15
Limestone	15	60
Shale	60	75
Shale	75	80
Shale	80	100

This well was filled with natural earth material from 100' to 20'. cement was ran from 20' to 5'. It was topped with natural earth material.

(Use a second sheet if needed)

10. Screen: Manufacturer's name _____
Type _____ Dia. _____
Slot/gauze _____ Length _____
Set between _____ ft. and _____ ft.
_____ ft. and _____ ft.
Gravel pack? _____ Size range of material _____
11. Static water level: _____ mo./day/yr.
_____ ft. below land surface Date _____
12. Pumping level below land surfaces:
_____ ft. after _____ hrs. pumping _____ g.p.m.
_____ ft. after _____ hrs. pumping _____ g.p.m.
Estimated maximum yield 12 g.p.m.
13. Water sample submitted: _____ mo./day/yr.
Yes _____ No _____ Date _____
14. Well head completion:
_____ Pitless adapter _____ Inches above grade
15. Well grouted? _____
With: _____ Neat cement _____ Bentonite _____ Concrete
Depth: From _____ ft. to _____ ft.
16. Nearest source of possible contamination:
ft. _____ Direction _____ Type _____
Well disinfected upon completion? _____ Yes _____ No
17. Pump: _____ Not installed
Manufacturer's name _____
Model number _____ HP _____ Volts _____
Length of drop pipe _____ ft. capacity _____ g.p.m.
Type:
_____ Submersible _____ Turbine
_____ Jet _____ Reciprocating
_____ Centrifugal _____ Other

18. Elevation: Topography: _____ Hill
_____ Slope
 Upland
_____ Valley

19. Remarks:

20. Water well contractor's certification:
This well was drilled under my jurisdiction and this report is true to the best of my knowledge and belief.
Blades Drilling Co. 157
Business name _____ License No. _____
Address 1000 S. 10th St Topeka, KS
Signed James P. Blades Date 2-24-97
Authorized representative

23 - 70
10 SE 1/4 SE 1/4