


USE TYPEWRITER OR BALL POINT PEN-PRESS FIRMLY, PRINT CLEARLY.

WATER WELL RECORD
KSA 82a-1201-1215

Kansas Department of Health and Environment-Division of Environment
(Water well Contractors)
Topeka, Kansas 66620

1. Location of well: County Butler Fraction SW 1/4 SE 1/4 SE 1/4 Section number 10 Township number T 23 S R 7 E/W Range number 7

2. Distance and direction from nearest town or city: 2 miles NW Casseday, Ks
Street address of well location if in city: Casseday, Ks
3. Owner of well: Henry Oldfield
R.R. or street: RR1
City, state, zip code: Casseday, Ks

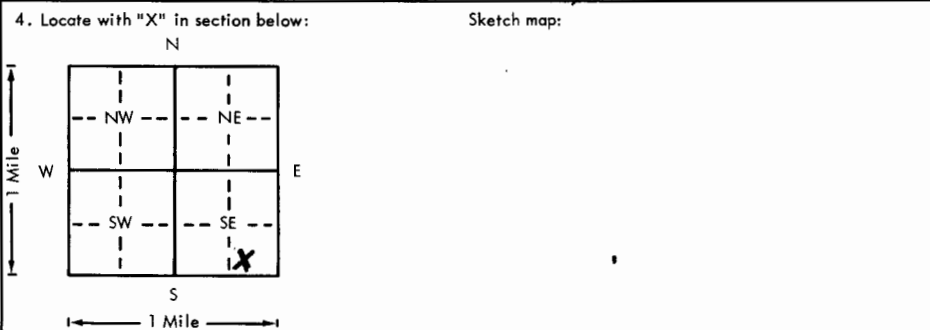

6. Bore hole dia. 8 in. Completion date 1-24-79
Well depth 75 ft.
7. Cable tool Rotary Driven Dug
 Hollow rod Jetted Bored Reverse rotary
8. Use: Domestic Public supply Industry
 Irrigation Air conditioning Stock
 Lawn Oil field water Other
9. Casing: Material _____ Height: Above or below
Threaded _____ Welded _____ Surface _____ in.
RMP _____ PVC _____ Weight _____ lbs./ft.
Dia. _____ in. to _____ ft. depth Wall Thickness: inches or
Dia. _____ in. to _____ ft. depth Gage No. _____

5. Type and color of material	From	To
Top Soil		
Shale	0	3
Limestone	3	7
Shale	7	67
	67	75

10. Screen: Manufacturer's name _____
Type _____ Dia. _____
Slot/gauze _____ Length _____
Set between _____ ft. and _____ ft.
_____ ft. and _____ ft.
Gravel pack? Size range of material _____
11. Static water level: _____ mo./day/yr.
_____ ft. below land surface Date _____
12. Pumping level below land surfaces:
_____ ft. after _____ hrs. pumping _____ g.p.m.
_____ ft. after _____ hrs. pumping _____ g.p.m.
Estimated maximum yield 14 g.p.m.
13. Water sample submitted: _____ mo./day/yr.
 Yes No Date _____

This well was filled with natural earth material from 75' to 20'. Cement was ran from 20' to 5'. Natural earth material was used to fill to the top.

14. Well head completion: _____ Pitless adapter _____ Inches above grade
15. Well grouted? _____
With: Neat cement Bentonite Concrete
Depth: From _____ ft. to _____ ft.
16. Nearest source of possible contamination:
ft. _____ Direction _____ Type _____
Well disinfected upon completion? Yes No
17. Pump: _____ Not installed
Manufacturer's name _____
Model number _____ HP _____ Volts _____
Length of drop pipe _____ ft. capacity _____ g.p.m.
Type:
 Submersible Turbine
 Jet Reciprocating
 Centrifugal Other

18. Elevation: _____
19. Remarks: _____
Topography:
 Hill
 Slope
 Upland
 Valley

20. Water well contractor's certification:
This well was drilled under my jurisdiction and this report is true to the best of my knowledge and belief.
Bladsoe Drilling Co. 152
Business name License No.
Address Strongs City
Signed Alyan P. Bladsoe Date 2-21-79
Authorized representative

23 - 20 10 SW SE SE
T R W Sec 1/4 1/4 1/4