


USE TYPEWRITER OR BALL POINT PEN—PRESS FIRMLY, PRINT CLEARLY.

WATER WELL RECORD  
KSA 82a-1201-1215

Kansas Department of Health and Environment—Division of Environment (Water well Contractors) Topeka, Kansas 66620

1. Location of well: County Butler Fraction SE 1/4 NE 1/4 NE 1/4 Section number 21 Township number T 23 S R 7 E/W Range number

2. Distance and direction from nearest town or city: Street address of well location if in city: 3. Owner of well: Arthur Stevens R.R. or street: RR1 City, state, zip code: Cassoday, Kansas

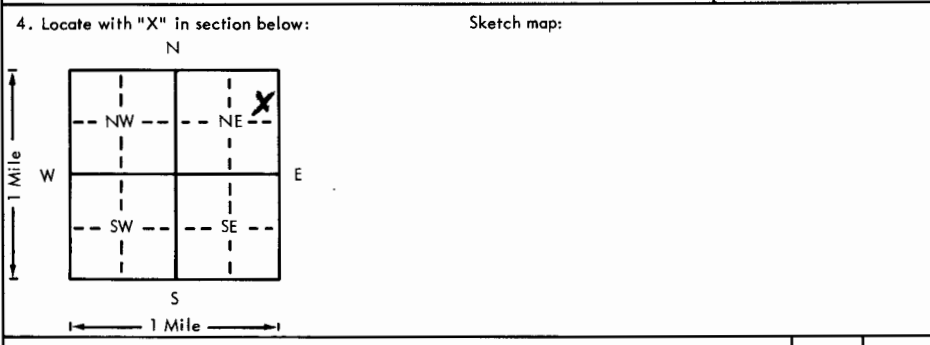

6. Bore hole dia. 8 1/2 in. Completion date 11-12-77 Well depth 100 ft.  
7.  Cable tool  Rotary  Driven  Dug  Hollow rod  Jetted  Bored  Reverse rotary  
8. Use:  Domestic  Public supply  Industry  Irrigation  Air conditioning  Stock  Lawn  Oil field water  Other  
9. Casing: Material \_\_\_\_\_ Height Above or below Threaded \_\_\_\_\_ Welded \_\_\_\_\_ Surface 36 in. RMP \_\_\_\_\_ PVC  Weight \_\_\_\_\_ lbs./ft. Dia. 5 in. to 100 ft. depth | Wall Thickness: inches or Dia. \_\_\_\_\_ in. to \_\_\_\_\_ ft. depth | gage No. 1258

5. Type and color of material

	From	To
Top Soil	0	5
Shale	5	7
Shale	7	10
Limestone	10	62
Shale	62	73
Shale	73	85
Shale	85	100

10. Screen: Manufacturer's name \_\_\_\_\_ Type ~~\_\_\_\_\_~~ Dia. \_\_\_\_\_ Slot/gauze slot Length \_\_\_\_\_ Set between 52 ft. and 62 ft. \_\_\_\_\_ ft. and \_\_\_\_\_ ft. Gravel pack?  Size range of material 3/8  
11. Static water level: \_\_\_\_\_ mo./day/yr. 22 ft. below land surface Date 11-8-76  
12. Pumping level below land surfaces: \_\_\_\_\_ ft. after \_\_\_\_\_ hrs. pumping \_\_\_\_\_ g.p.m. \_\_\_\_\_ ft. after \_\_\_\_\_ hrs. pumping \_\_\_\_\_ g.p.m. Estimated maximum yield 5 g.p.m.  
13. Water sample submitted: \_\_\_\_\_ mo./day/yr. Yes  No  Date \_\_\_\_\_  
14. Well head completion: well seal Pitless adapter \_\_\_\_\_ Inches above grade  
15. Well grouted?  With:  Neat cement  Bentonite  Concrete Depth: From 15 ft. to 5 ft.  
16. Nearest source of possible contamination: \_\_\_\_\_ ft. 1 mile Direction NW Type cattle Well disinfected upon completion?  Yes  No  
17. Pump:  Not installed Manufacturer's name \_\_\_\_\_ Model number \_\_\_\_\_ HP \_\_\_\_\_ Volts \_\_\_\_\_ Length of drop pipe \_\_\_\_\_ ft. capacity \_\_\_\_\_ g.p.m. Type: \_\_\_\_\_ Submersible \_\_\_\_\_ Turbine \_\_\_\_\_ Jet \_\_\_\_\_ Reciprocating \_\_\_\_\_ Centrifugal \_\_\_\_\_ Other \_\_\_\_\_

18. Elevation: Topography:  Hill  Slope  Upland  Valley  
19. Remarks: (Use a second sheet if needed)  
20. Water well contractor's certification: This well was drilled under my jurisdiction and this report is true to the best of my knowledge and belief. Bledsoe Drilling Co 152 Business name License No. Address Strong City, Ks Signed Wayen P. Bledsoe 2-1-78 authorized representative

23 - 20 21 SE NE NE 1/4 1/4