

1 LOCATION OF WATER WELL: County: <u>Harvey</u>	Fraction <u>SW</u> $\frac{1}{4}$ <u>SW</u> $\frac{1}{4}$ <u>SW</u> $\frac{1}{4}$	Section Number <u>33</u>	Township Number T <u>24</u> S	Range Number R <u>1</u> <u>EW</u>
--	---	-----------------------------	----------------------------------	--------------------------------------

Distance and direction from nearest town or city street address of well if located within city?

125th & Broadway, Sedgwick, KS.

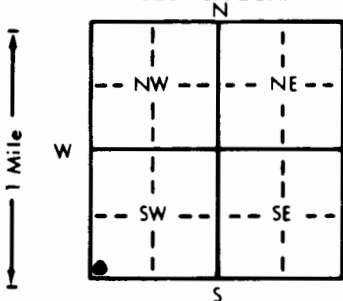
2 WATER WELL OWNER:

RR#, St. Address, Box #: Don Franz  
125th & Broadway  
City, State, ZIP Code: Sedgwick, KS.

Board of Agriculture, Division of Water Resources

Application Number:

3 LOCATE WELL'S LOCATION WITH AN "X" IN SECTION BOX:

4 DEPTH OF COMPLETED WELL 26 1/2' ft. ELEVATION:Depth(s) Groundwater Encountered 1.20' ft. 2. ft. 3. ft.WELL'S STATIC WATER LEVEL 19.85 ft. below land surface measured on mo/day/yr 1-25-96

Pump test data: Well water was ft. after hours pumping gpm

Est. Yield gpm: Well water was ft. after hours pumping gpm

Bore Hole Diameter 8 1/2" in. to 26 1/2' ft., and in. to ft.

WELL WATER TO BE USED AS: 5 Public water supply 8 Air conditioning 11 Injection well

1 Domestic 3 Feedlot 6 Oil field water supply 9 Dewatering 12 Other (Specify below)

2 Irrigation 4 Industrial 7 Lawn and garden only 10 Monitoring well Air Sparge Well

Was a chemical/bacteriological sample submitted to Department? Yes No; If yes, mo/day/yr sample was submitted

Water Well Disinfected? Yes No

5 TYPE OF BLANK CASING USED:

1 Steel 3 RMP (SR)

2 PVC 4 ABS

5 Wrought iron

6 Asbestos-Cement

7 Fiberglass

8 Concrete tile

9 Other (specify below)

CASING JOINTS: Glued Clamped

Welded

Threaded

Blank casing diameter 2.375 in. to 20'6" ft., Dia. in. to ft., Dia. in. to SDR 13 ft.Casing height above land surface Flush in., weight lbs./ft. Wall thickness or gauge No. SCH 40

TYPE OF SCREEN OR PERFORATION MATERIAL:

1 Steel 3 Stainless steel

2 Brass 4 Galvanized steel

5 Fiberglass

6 Concrete tile

7 PVC

8 RMP (SR)

9 ABS

10 Asbestos-cement

11 Other (specify)

12 None used (open hole)

SCREEN OR PERFORATION OPENINGS ARE:

1 Continuous slot

2 Louvered shutter

3 Mill slot

4 Key punched

5 Gauzed wrapped

6 Wire wrapped

7 Torch cut

8 Saw cut

9 Drilled holes

10 Other (specify)

11 None (open hole)

SCREEN-PERFORATED INTERVALS: From 25'6" ft. to 20'6" ft., From ft. to ft.

From ft. to ft., From ft. to ft.

GRAVEL PACK INTERVALS: From 25'6" ft. to 18' ft., From ft. to ft.

From ft. to ft., From ft. to ft.

6 GROUT MATERIAL:

1 Neat cement

2 Cement grout3 Bentonite

4 Other

Grout intervals: From 18' ft. to 14' ft., From 14' ft. to 0' ft., From ft. to ft.

What is the nearest source of possible contamination:

1 Septic tank

2 Sewer lines

3 Watertight sewer lines

4 Lateral lines

5 Cess pool

6 Seepage pit

7 Pit privy

8 Sewage lagoon

9 Feedyard

10 Livestock pens

11 Fuel storage

12 Fertilizer storage

13 Insecticide storage

14 Abandoned water well

15 Oil well/Gas well

16 Other (specify below)

Direction from well? EastHow many feet? 15'

FROM	TO	LITHOLOGIC LOG	FROM	TO	PLUGGING INTERVALS
0	.50	Asphalt			
.50	3	Dk brn clay, moist to dry, tight, no odor.			
3	9.25	Red brn clay w/ dk brn mottling, dry, stiff, no odor.			
9.25	13	Red brn sandy clay, moist, no odor, fine-med grained sand.			
13	18	Tan gray clayey sand to sand, fine-med grained, moist, slight odor, mottling.			
18	26.50	Gray fine-med grained sand w/ gray green mottled clay lens. Wet at 20', strong odor.			

F.M. OK'd by Don Taylor7 CONTRACTOR'S OR LANDOWNER'S CERTIFICATION: This water well was (1) constructed (2) reconstructed, or (3) plugged under my jurisdiction and was completed on (mo/day/year) 1-25-96 and this record is true to the best of my knowledge and belief. KansasWater Well Contractor's License No. 539 This Water Well Record was completed on (mo/day/yr) 2-11-96under the business name of JB Environmental Drilling by (signature) James Becker