

1 LOCATION OF WATER WELL: County: Harvey	Fraction NW 1/4 NW 1/4 SW 1/4	Section Number 16	Township Number T 24 S	Range Number R 1-E
----------------------------------------------------	-----------------------------------------	-----------------------------	----------------------------------	------------------------------

Distance and direction from nearest town or city street address of well if located within city?

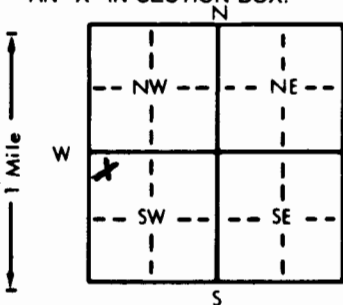
4 1/2 SOUTH OF NEWTON KS.2 WATER WELL OWNER: **Paul Dubois**RR#, St. Address, Box # : **RR#5**

Board of Agriculture, Division of Water Resources

City, State, ZIP Code : **Newton, Kansas 67114**

Application Number:

3 LOCATE WELL'S LOCATION WITH AN "X" IN SECTION BOX:

4 DEPTH OF COMPLETED WELL **56'** ft. ELEVATION: **FLAT**Depth(s) Groundwater Encountered **1** **40** ft. 2. ft. 3. ft.WELL'S STATIC WATER LEVEL **15** ft. below land surface measured on mo/day/yr **8-1-88**Pump test data: Well water was **25** ft. after **1** hours pumping **80** gpmEst. Yield **80** gpm: Well water was **25** ft. after **1** hours pumping **80** gpmBore Hole Diameter **9"** in. to **56** ft., and **9"** in. to **56** ft.

WELL WATER TO BE USED AS:

<input checked="" type="checkbox"/> Domestic	3 Feedlot	6 Oil field water supply	9 Dewatering	12 Other (Specify below)
2 Irrigation	4 Industrial	7 Lawn and garden only	10 Monitoring well	

Was a chemical/bacteriological sample submitted to Department? Yes ☒ No ☐ If yes, mo/day/yr sample was submittedWater Well Disinfected? ☒ Yes ☐ No

5 TYPE OF BLANK CASING USED:

- | | |
|-----------------------------------------|------------|
| 1 Steel | 3 RMP (SR) |
| <input checked="" type="checkbox"/> PVC | 4 ABS |

5 Wrought iron

8 Concrete tile

CASING JOINTS: Glued ☒ Clamped ☐

6 Asbestos-Cement

9 Other (specify below)

Welded ☐

7 Fiberglass

Threaded ☐Blank casing diameter **5"** in. to **36** ft., Dia **36** in. to **56** ft., Dia **56** in. to **56** ft.Casing height above land surface **30** in., weight **2.29** lbs./ft. Wall thickness or gauge No. **214**

TYPE OF SCREEN OR PERFORATION MATERIAL:

- | | | | | |
|---------|--------------------|-----------------|------------|--------------------------|
| 1 Steel | 3 Stainless steel | 5 Fiberglass | 8 RMP (SR) | 10 Asbestos-cement |
| 2 Brass | 4 Galvanized steel | 6 Concrete tile | 9 ABS | 11 Other (specify) |
| | | | | 12 None used (open hole) |

SCREEN OR PERFORATION OPENINGS ARE:

- | | | | | |
|--------------------|---------------|------------------|---------------------------------------------|---------------------|
| 1 Continuous slot | 3 Mill slot | 5 Gauzed wrapped | <input checked="" type="checkbox"/> Saw cut | 11 None (open hole) |
| 2 Louvered shutter | 4 Key punched | 6 Wire wrapped | 9 Drilled holes | |
| | | 7 Torch cut | 10 Other (specify) | |



6 GROUT MATERIAL:

☒ Neat cement

2 Cement grout

3 Bentonite

4 Other


What is the nearest source of possible contamination:

- | | | | | |
|-------------------------------------------------|-----------------|-----------------|------------------------|--------------------------|
| <input checked="" type="checkbox"/> Septic tank | 4 Lateral lines | 7 Pit privy | 10 Livestock pens | 14 Abandoned water well |
| 2 Sewer lines | 5 Cess pool | 8 Sewage lagoon | 11 Fuel storage | 15 Oil well/Gas well |
| 3 Watertight sewer lines | 6 Seepage pit | 9 Feedyard | 12 Fertilizer storage | 16 Other (specify below) |
| | | | 13 Insecticide storage | |

Direction from well?

4 1/2 SOUTH

How many feet?

80

FROM	TO	LITHOLOGIC LOG	FROM	TO	PLUGGING INTERVALS
0	26	Clay			
26	28	Sand			
28	30	Rock ()			
30	33	CLAY			
33	40	Clay			
40	50	Sand Gravel			
	50	Clay			
	53	Shale			
	56	Shale Bottom			

7 CONTRACTOR'S OR LANDOWNER'S CERTIFICATION: This water well was ☒ constructed, (2) reconstructed, or (3) plugged under my jurisdiction and wascompleted on (mo/day/year) **8-1-88** and this record is true to the best of my knowledge and belief. KansasWater Well Contractor's License No. **362** This Water Well Record was completed on (mo/day/yr) **8-1-88**under the business name of **Martin Supply** by (signature) **Dwight Johnson**