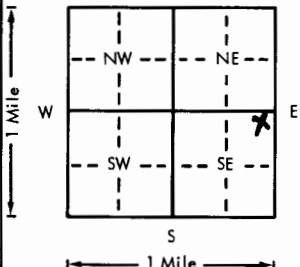


USE TYPEWRITER OR BALL
POINT PEN-PRESS FIRMLY,
PRINT CLEARLY.

WATER WELL RECORD
KSA 82a-1201-1215

Kansas Department of Health and
Environment-Division of Environment
(Water well Contractors)
Topeka, Kansas 66620

1. Location of well:		County Harvey	Fraction NE 1/4 NE 1/4 SE 1/4	Section number 25	Township number T 24 S R 1 E	Range number 1
Distance and direction from nearest town or city: 4 East of old 81 Hwy and 125th North and 1 1/2 North and 1/2 West. Newton, Kansas		3. Owner of well: 4-N's Inc. Sid Nattier R.R. or street: Rt. 5 City, state, zip code: Newton, Kansas				
Sketch map: 		6. Bore hole dia. 11 in. Completion date Well depth 85 ft. 12-17-76				
5. Type and color of material		7. <input checked="" type="checkbox"/> Cable tool <input checked="" type="checkbox"/> Rotary <input type="checkbox"/> Driven <input type="checkbox"/> Dug <input type="checkbox"/> Hollow rod <input type="checkbox"/> Jetted <input type="checkbox"/> Bored <input type="checkbox"/> Reverse rotary				
Sandy Soil		8. Use: <input type="checkbox"/> Domestic <input type="checkbox"/> Public supply <input checked="" type="checkbox"/> Industry <input type="checkbox"/> Irrigation <input type="checkbox"/> Air conditioning <input checked="" type="checkbox"/> Stock <input type="checkbox"/> Lawn <input type="checkbox"/> Oil field water <input type="checkbox"/> Other				
Clay		9. Casing: Material styrene Height: Above or below <input checked="" type="checkbox"/> Threaded <input type="checkbox"/> Welded <input checked="" type="checkbox"/> Surface 12 in. RMP <input checked="" type="checkbox"/> PVC Weight 5 lbs./ft. Dia. 5 in. to 85 ft. depth Wall Thickness: inches or Dia. 5 in. to 85 ft. depth gage No. .200				
Shale		10. Screen: Manufacturer's name Sunflower Plastic Type styrene Dia. 5" Slot 1/16 .06 Length 65' Set between 20 ft. and 85 ft. ft. and 85 ft. Gravel pack? yes Size range of material 1/4-1/8"				
		11. Static water level: 20 ft. below land surface Date 12-17-76 mo./day/yr.				
		12. Pumping level below land surfaces: ____ ft. after ____ hrs. pumping ____ g.p.m. ____ ft. after ____ hrs. pumping ____ g.p.m. Estimated maximum yield ____ g.p.m.				
		13. Water sample submitted: ____ mo./day/yr. <input type="checkbox"/> Yes <input type="checkbox"/> No Date ____				
		14. Well head completion: 12 capped <input type="checkbox"/> Pitless adapter 12 Inches above grade				
		15. Well grouted? yes With: <input type="checkbox"/> Neat cement <input checked="" type="checkbox"/> Bentonite <input checked="" type="checkbox"/> Concrete Depth: From 40' ft. to 14 ft.				
		16. Nearest source of possible contamination: NONE ft. ____ Direction ____ Type ____ Well disinfected upon completion? <input checked="" type="checkbox"/> Yes <input type="checkbox"/> No				
		17. Pump: <input checked="" type="checkbox"/> Not installed Manufacturer's name ____ Model number ____ HP ____ Volts ____ Length of drop pipe ____ ft. capacity ____ g.p.m. Type: <input type="checkbox"/> Submersible <input type="checkbox"/> Turbine <input type="checkbox"/> Jet <input type="checkbox"/> Reciprocating <input type="checkbox"/> Centrifugal <input type="checkbox"/> Other				
18. Elevation:		20. Water well contractor's certification: This well was drilled under my jurisdiction and this report is true to the best of my knowledge and belief. Harp Well & Pump 236 Business name License No. 67209 Address Wichita, Kansas Signed Dr. Arnold Date 12-20-76 Authorized representative				
19. Remarks: Flat Ground No apparent source for contamination.						