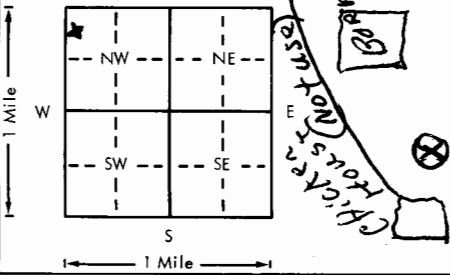



USE TYPEWRITER OR BALL
POINT PEN-PRESS FIRMLY,
PRINT CLEARLY.

WATER WELL RECORD
KSA 82a-1201-1215

Kansas Department of Health and
Environment-Division of Environment
(Water well Contractors)
Topeka, Kansas 66620

1. Location of well: County <u>HARVEY</u> Sedgwick		Fraction <u>SW 1/4 NW 1/4 NW 1/4</u>	Section number <u>34</u>	Township number <u>24</u>	Range number <u>1</u>
X Distance and direction from nearest town or city: <u>8 mi. E of Sedgwick and 1/4 No.</u>		3. Owner of well: <u>ROBERT H. OSBORN</u> R.R. or street: <u>Rt 1</u> City, state, zip code: <u>Sedgwick, KS. 67135</u>			
4. Locate with "X" in section below: 		Sketch map: 		6. Bore hole dia. <u>8 3/4</u> in. Completion date <u>7-24-78</u> Well depth <u>60</u> ft.	
5. Type and color of material		From	To	7. Cable tool <input checked="" type="checkbox"/> Rotary <input type="checkbox"/> Driven <input type="checkbox"/> Dug <input type="checkbox"/> Hollow rod <input type="checkbox"/> Jetted <input type="checkbox"/> Bored <input type="checkbox"/> Reverse rotary	
<u>TOP SOIL</u>		<u>0</u>	<u>2</u>	8. Use: <input checked="" type="checkbox"/> Domestic <input type="checkbox"/> Public supply <input type="checkbox"/> Industry <input type="checkbox"/> Irrigation <input type="checkbox"/> Air conditioning <input type="checkbox"/> Stock <input type="checkbox"/> Lawn <input type="checkbox"/> Oil field water <input type="checkbox"/> Other	
<u>BROWN Sun Bae</u>		<u>2</u>	<u>16</u>	9. Casing: Material <u>PVC</u> Height: Above or below Threaded <input type="checkbox"/> Welded <input type="checkbox"/> Surface <u>16</u> in. RMP <u>PVC</u> Weight <u>64</u> lbs./ft.	
<u>SAND (Fine)</u>		<u>16</u>	<u>60</u>	Dia. <u>5</u> in. to <u>50</u> ft. depth Wall Thickness: inches or Dia. <u>5</u> in. to <u>50</u> ft. depth gage No. <u>250</u>	
				10. Screen: Manufacturer's name <u>M. P. I.</u> Type <u>P.V.C.</u> Dia. <u>5</u> Slot gauge <u>25mm</u> Length <u>10</u> Set between <u>50</u> ft. and <u>60</u> ft. Gravel pack? <u>YES</u> Size range of material <u>4/20-30</u>	
				11. Static water level: <u>16</u> ft. below land surface Date <u>7-24-78</u>	
				12. Pumping level below land surfaces: ____ ft. after ____ hrs. pumping ____ g.p.m. ____ ft. after ____ hrs. pumping ____ g.p.m. Estimated maximum yield <u>30</u> g.p.m.	
				13. Water sample submitted: <u>X</u> Yes <u>X</u> No Date ____	
				14. Well head completion: <u>CAP</u> <u>16</u> Pitless adapter <u>16</u> inches above grade	
				15. Well grouted? <u>YES</u> With: <u>X</u> Neat cement <input type="checkbox"/> Bentonite <input type="checkbox"/> Concrete Depth: From <u>0</u> ft. to <u>10</u> ft.	
				16. Nearest source of possible contamination: ft. <u>50</u> Direction <u>SO</u> Type <u>CHICKEN HOUSE</u> Well disinfected upon completion? <u>X</u> Yes <input type="checkbox"/> No	
				17. Pump: <u>X</u> Not installed Manufacturer's name ____ Model number ____ HP ____ Volts ____ Length of drop pipe ____ ft. capacity ____ g.p.m. Type: <input type="checkbox"/> Submersible <input type="checkbox"/> Turbine <input type="checkbox"/> Jet <input type="checkbox"/> Reciprocating <input type="checkbox"/> Centrifugal <input type="checkbox"/> Other	
18. Elevation:		19. Remarks:			
Topography: <input type="checkbox"/> Hill <input checked="" type="checkbox"/> Slope <input checked="" type="checkbox"/> Upland <input type="checkbox"/> Valley		(Use a second sheet if needed)			
		20. Water well contractor's certification: This well was drilled under my jurisdiction and this report is true to the best of my knowledge and belief. <u>PREWITT CONST 353</u> Business name <u>Box 7144</u> License No. ____ Address <u>Box 7144</u> Signed <u>Archie C. Prewitt</u> Date <u>7-24-78</u> Authorized representative			