


1 LOCATION OF WATER WELL: County: <u>Harvey</u> Fraction: <u>SW 1/4 SW 1/4 NW 1/4</u> Section Number: <u>28</u> Township Number: <u>T 240 S</u> Range Number: <u>R 10 W</u>

Distance and direction from nearest town or city street address of well if located within city?

9412 S. Kansas

2 WATER WELL OWNER: <u>Dan Watts</u> RR#, St. Address, Box # <u>1201 Sunnydale Way</u> City, State, ZIP Code <u>Valley Center KS 67147-80</u>	Board of Agriculture, Division of Water Resources Application Number:
---	--

3 LOCATE WELL'S LOCATION WITH AN "X" IN SECTION BOX:	4 DEPTH OF COMPLETED WELL: ft. ELEVATION: ft.
--	---

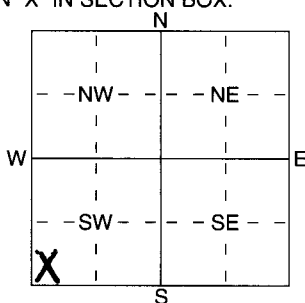

Depth(s) Groundwater Encountered: ft. 2 ft. 3 ft.
 WELL'S STATIC WATER LEVEL: 15 ft. below land surface measured on mo/day/yr 4-2-04
 Pump test data: Well water was ft. after hours pumping gpm
 Est. Yield: 18 gpm: Well water was ft. after hours pumping gpm
 WELL WATER TO BE USED AS:
 1 Domestic 3 Feedlot 6 Oil field water supply 8 Air conditioning 11 Injection well
 2 Irrigation 4 Industrial 7 Domestic (lawn & garden) 10 Dewatering 12 Other (Specify below)

Was a chemical/bacteriological sample submitted to Department? Yes No X; If yes, mo/day/yr sample was submitted
 Water Well Disinfected? Yes X No

5 TYPE OF BLANK CASING USED: 1 Steel 3 RMP (SR) 2 PVC 4 ABS	5 Wrought iron 8 Concrete tile 6 Asbestos-Cement 9 Other (specify below) 7 Fiberglass	CASING JOINTS: Glued <u>X</u> Clamped Welded Threaded
---	---	---

Blank casing diameter 5 in. to 30 ft., Dia 2.40 in. to ft., Dia in. to ft.
 Casing height above land surface 12 in., weight 2.40 lbs./ft. Wall thickness or gauge No. 160psi

TYPE OF SCREEN OR PERFORATION MATERIAL:			
1 Steel 3 Stainless Steel 5 Fiberglass 8 RMP (SR)	10 Asbestos-Cement		
2 Brass 4 Galvanized Steel 6 Concrete tile 9 ABS	11 Other (Specify)		
12 None used (open hole)			

SCREEN OR PERFORATION OPENINGS ARE:			
1 Continuous slot 3 Mill slot 5 Guazed wrapped 8 Saw cut 11 None (open hole)			
2 Louvered shutter 4 Key punched 6 Wire wrapped 9 Drilled holes			
7 Torch cut 10 Other (specify) ft.			

SCREEN-PERFORATED INTERVALS: From <u>30</u> ft. to <u>80</u> ft., From ft. to ft.			
GRAVEL PACK INTERVALS: From <u>15</u> ft. to <u>80</u> ft., From ft. to ft.			

6 GROUT MATERIAL: 1 Neat cement 15 2 Cement grout 3 Bentonite 4 Other

Grout Intervals: From 3 ft. to 15 ft., From ft. to ft., From ft. to ft.

What is the nearest source of possible contamination:			
1 Septic tank 4 Lateral lines 7 Pit privy 10 Livestock pens 14 Abandoned water well			
2 Sewer lines 5 Cess pool 8 Sewage lagoon 11 Fuel storage 15 Oil well/Gas well			
3 Watertight sewer lines 6 Seepage pit 9 Feedyard 12 Fertilizer storage 16 Other (specify below)			
13 Insecticide storage <u>Open field</u>			

Direction from well? How many feet?

FROM	TO	LITHOLOGIC LOG	FROM	TO	PLUGGING INTERVALS
0	2	topsoil			
2	10	clay			
10	35	fine/med sand			
35	37	shale			
37	58	fine/med sand			
58	80	shale			

7 CONTRACTOR'S OR LANDOWNER'S CERTIFICATION: This water well was (1) constructed, (2) reconstructed, or (3) plugged under my jurisdiction and was completed on (mo/day/year) <u>4-2-04</u> and this record is true to the best of my knowledge and belief. Kansas Water Well Contractor's Licence No. <u>318</u> This Water Well Record was completed on (mo/day/yr) <u>4-2-04</u> under the business name of <u>Wenger Drilling Inc</u> by (signature) <u>Michelle George</u>
--