

CORRECTION(S) TO WATER WELL RECORD (WWC-5)  
(to rectify lacking or incorrect information)

Location listed as:

Section-Township-Range: \_\_\_\_\_

Fraction ( 1/4 1/4 1/4): \_\_\_\_\_

County: Harvey

Location changed to:

33-24S-1E

SW SW SW

Other changes: Initial statements: Sedgwick County

Changed to: Harvey County

Comments: \_\_\_\_\_

verification method: Written & legal descriptions, area road map, and mapping tool & aerial photos on KGS website.

initials: DRJ date: 3/12/2010


submitted by: Kansas Geological Survey, Data Resources Library, 1930 Constant Ave., Lawrence, KS 66047-3726  
to: Kansas Dept of Health & Environment, Bureau of Water, 1000 SW Jackson, Suite 420, Topeka, KS 66612-1367.

SUE-3

1	LOCATION OF WATER WELL:	Fraction	Section Number	Township Number	Range Number
	County: <u>Sedgwick</u>	<u>SW 1/4 SW 1/4 SW 1/4</u>	<u>33</u>	<u>24</u>	<u>1</u> <input checked="" type="checkbox"/> EW

Distance and direction from nearest town or city street address of well if located within city?  
10718 South Kansas Road, Sedgwick, KS 67135

2	WATER WELL OWNER: <u>North 81 Tractor Supply</u>	Board of Agriculture, Division of Water Resources
	RR #, St. Address, Box #: <u>10718 S. Kansas Road</u>	Application Number:
	City, State, ZIP Code: <u>Sedgwick KS 67135</u>	

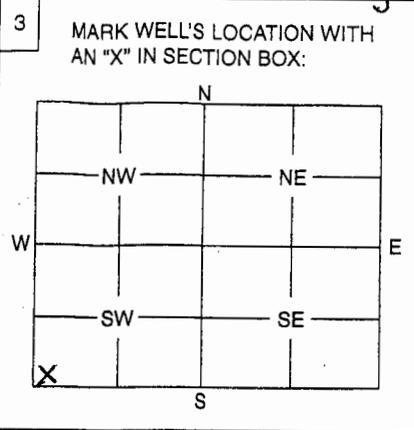

4 DEPTH OF WELL ..... 23 ft.

WELL'S STATIC WATER LEVEL ..... 21 ft.

WELL WAS USED AS:

1 Domestic	5 Public Water Supply	9 Dewatering
2 Irrigation	6 Oil Field Water Supply	10 Monitoring Well
3 Feedlot	7 Domestic (Lawn & Garden)	11 Injection Well
4 Industrial	8 Air Conditioning	<input checked="" type="checkbox"/> 12 Other <u>SUE</u>

Was a chemical / bacteriological sample submitted to Department? Yes ..... No  .....

If yes, mo/day/yr sample was submitted .....

Water Well Disinfected: Yes ..... No  .....

5 TYPE OF BLANK CASING USED:

1 Steel	3 RMP (SR)	5 Wrought	7 Fiberglass	9 Other (Specify below)
<input checked="" type="checkbox"/> 2 PVC	4 ABS	6 Asbestos-Cement	8 Concrete Tile	

Blank casing diameter ..... 4 in. Was casing pulled? Yes  No ..... If yes, how much ..... 3'

Casing height above or below land surface ..... 36 in.

6 GROUT PLUG MATERIAL: 1 Neat cement 2 Cement grout  3 Bentonite 4 Other .....

Grout Plug Intervals: From 3 ft. to 23 ft., From ..... ft. to ..... ft., From ..... to ..... ft.

What is the nearest source of possible contamination:

1 Septic tank	6 Seepage pit	11 Fuel storage	16 Other (specify below)
2 Sewer lines	7 Pit privy	12 Fertilizer storage	
<input checked="" type="checkbox"/> 3 Watertight sewer lines	8 Sewage lagoon	13 Insecticide storage	
4 Lateral lines	9 Feedyard	14 Abandoned water well	
5 Cess pool	10 Livestock pens	15 Oil well/Gas well	

Direction from well? ..... E ..... How many feet? ..... 40 .....

FROM	TO	PLUGGING MATERIALS
<u>23'</u>	<u>3'</u>	<u>Bentonite chips</u>
<u>3'</u>	<u>0'</u>	<u>Native material</u>

7 CONTRACTOR'S OF LANDOWNER'S CERTIFICATION: This water well was plugged under my jurisdiction and was completed on (mo/day/year) 12-27-09 and this record is true to the best of my knowledge and belief. Kansas Water Well Contractor's License No. .... This Water Well Record was completed on (mo/day/year) 2-5-10 under the business name of GreenField Contractors by (signature) Jan Peabram

INSTRUCTIONS: Use typewriter or ball point pen. Please press firmly and print clearly. Please fill in blanks, underline or circle the correct answers. Send top three copies to Kansas Department of Health and Environment, Bureau of Water, Geology Section, 1000 SW Jackson St., Ste. 420, Topeka, Kansas 66612-1367. Telephone: 785/296-5522. Send one to Water Well Owner and retain one for your records.