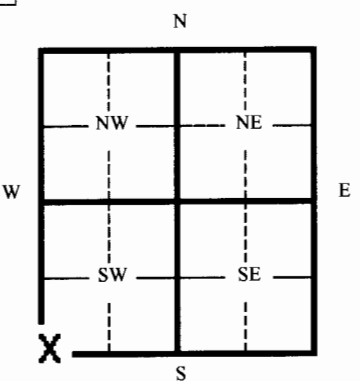


1 LOCATION OF WATER WELL:	Fraction	Section Number	Township Number	Range Number
County: <b>Harvey</b>	<b>SW 1/4 SW 1/4 SW 1/4</b>	<b>33</b>	<b>24</b>	<b>1-East</b>

Distance and direction from nearest town or city street address of well if located within city?  
**10718 S. Kansas Road, Sedgwick, Kansas**

2 WATER WELL OWNER: <b>North 81 Tractor Salvage</b> RR#, St. Address, Box # <b>10718 S. Kansas Road</b> City, State, ZIP Code : <b>Sedgwick, Kansas 67135</b>	Board of Agriculture, Division of Water Resources Application Number:
---	--

3 MARK WELL'S LOCATION WITH AN "X" IN SECTION BOX:  


4 DEPTH OF WELL 17.32 ft.  
WELL'S STATIC WATER LEVEL Dry ft.  
WELL WAS USED AS:  

1 Domestic  
2 Irrigation  
3 Feedlot  
4 Industrial

5 Public Water Supply  
6 Oil Field Water Supply  
7 Lawn and Garden (domestic)  
8 Air Conditioning

9 Dewatering  
10 Monitoring Well  
11 Injection Well  
12 Other Remedial

Was a chemical/bacteriological sample submitted to Department? Yes \_\_\_ No X  
If yes, mo/day/yr sample was submitted \_\_\_\_\_  
Water Well Disinfected: Yes \_\_\_ No X

5 TYPE OF BLANK CASING USED:  
1 Steel      3 RMP (SR)      5 Wrought      7 Fiberglass      9 Other (specify below)  
2 PVC      4 ABC      6 Asbestos-Cement      8 Concrete Tile  
Blank casing diameter 2.375 in. Was casing pulled? Yes \_\_\_ No X If yes, how much? N/A  
Casing height above or below land surface Unknown in. **Casing plugged; casing removed to depth of 3' BTOC.**

6 GROUT PLUG MATERIAL: 1 Neat cement    2 Cement grout    3 Bentonite    4 Other Concrete  
Grout Plug Intervals From 17.32 ft. to 3.0 ft. From 3.0 ft. to 0.0 ft. From \_\_\_ ft. to \_\_\_ ft.  
What is the nearest source of possible contamination:  

1 Septic tank  
2 Sewer lines  
3 Watertight sewer lines  
4 Lateral lines  
5 Cess Pool


6 Seepage pit  
7 Pit privy  
8 Sewage lagoon  
9 Feedyard  
10 Livestock pens

11 Fuel storage (former)  
12 Fertilizer storage  
13 Insecticide storage  
14 Abandoned water well  
15 Oil well/ Gas well

16 Other (specify below)

Direction from well? North How many feet? 35

FROM	TO	CODE	PLUGGING MATERIALS
<u>0.0</u>	<u>3.0</u>		<b>Concrete</b>
<u>3.0</u>	<u>17.32</u>		<b>Bentonite chips</b>

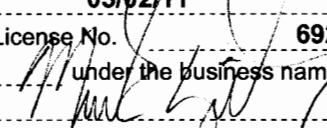7 CONTRACTOR'S OR LANDOWNER'S CERTIFICATION: This water well was plugged under my jurisdiction and was completed on (mo/day/yr) 03/02/11 and this record is true to the best of my knowledge and belief. Kansas Water Well Contractor's License No. 692 This Water Well Record was completed on (mo/day/yr) 03/07/11 under the business name of Quad State Services, Inc.  
by (signature) 

INSTRUCTIONS: Please fill in blanks and circle the correct answers. Send three copies to Kansas Department of Health and Environment, Bureau of Water, 1000 S W. Jackson St., Ste. 420, Topeka, Kansas 66620-0001. Telephone: 785-296-3565. Send one to Water Well Owner and retain one for your records.