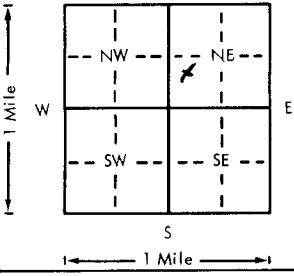
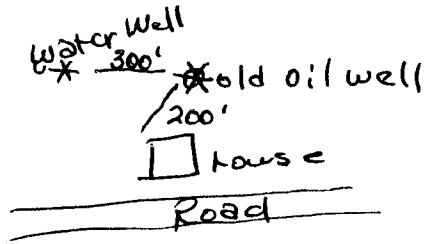


USE TYPEWRITER OR BALL
POINT PEN-PRESS FIRMLY,
PRINT CLEARLY.

WATER WELL RECORD
KSA 82a-1201-1215

Kansas Department of Health and
Environment-Division of Environment
(Water well Contractors)
Topeka, Kansas 66620

1. Location of well:	County Greenwood	Fraction 1/4 SW 1/4 NE 1/4	Section number 6	Township number T 24	Range number S R 12 E/W
2. Distance and direction from nearest town or city:	3 1/2 mi NE Hamilton, Ks				
Street address of well location if in city:	Hamilton, Ks				
3. Owner of well:	City, state, zip code:				
4. Locate with "X" in section below:	Sketch map:				
					
6. Bore hole dia. 9 in. Completion date 3/24/78	Well depth 59 ft.				
7. <input checked="" type="checkbox"/> Cable tool <input type="checkbox"/> Rotary <input type="checkbox"/> Driven <input type="checkbox"/> Dug	<input type="checkbox"/> Hollow rod <input type="checkbox"/> Jetted <input type="checkbox"/> Bored <input type="checkbox"/> Reverse rotary				
8. Use: <input checked="" type="checkbox"/> Domestic <input type="checkbox"/> Public supply <input type="checkbox"/> Industry	<input type="checkbox"/> Irrigation <input type="checkbox"/> Air conditioning <input type="checkbox"/> Stock				
<input type="checkbox"/> Lawn <input type="checkbox"/> Oil field water <input type="checkbox"/> Other					
9. Casing: Material <input type="checkbox"/> Height: Above or below	Threated <input type="checkbox"/> Welded <input type="checkbox"/> Surface 23 in.				
RMP <input type="checkbox"/> PVC <input checked="" type="checkbox"/> Weight <input type="checkbox"/> lbs./ft.	Dia. 6 in. to 59 ft. depth Wall Thickness: inches or				
Dia. <input type="checkbox"/> in. to <input type="checkbox"/> ft. depth	Dia. <input type="checkbox"/> in. to <input type="checkbox"/> ft. depth gage No. 280				
10. Screen: Manufacturer's name VINYL FLEX	Super pipe PVC 1120				
Type PVC Dia. 6	Slot/gauze 3/8" Length 20'				
Set between 39' ft. and 59' ft.	Set between <input type="checkbox"/> ft. and <input type="checkbox"/> ft.				
Gravel pack? <input checked="" type="checkbox"/> Size range of material 1/2"					
11. Static water level: <input type="checkbox"/> mo./day/yr.	6 ft. below land surface Date 2/20/78				
12. Pumping level below land surfaces:	<input type="checkbox"/> ft. after <input type="checkbox"/> hrs. pumping <input type="checkbox"/> g.p.m.				
<input type="checkbox"/> ft. after <input type="checkbox"/> hrs. pumping <input type="checkbox"/> g.p.m.	Estimated maximum yield <input type="checkbox"/> g.p.m.				
13. Water sample submitted: <input type="checkbox"/> mo./day/yr.	<input type="checkbox"/> Yes <input checked="" type="checkbox"/> No Date <input type="checkbox"/>				
14. Well head completion:	<input type="checkbox"/> Pitless adapter <input type="checkbox"/> Inches above grade				
15. Well grouted? <input checked="" type="checkbox"/>	With: <input type="checkbox"/> Neat cement <input type="checkbox"/> Bentonite <input checked="" type="checkbox"/> Concrete				
Depth: From 0 ft. to 10 ft.					
16. Nearest source of possible contamination:	ft. 200 Direction Stn Type Oil well				
Well disinfected upon completion? <input checked="" type="checkbox"/> Yes <input type="checkbox"/> No					
17. Pump: <input checked="" type="checkbox"/> Not installed	Manufacturer's name <input type="checkbox"/>				
Model number <input type="checkbox"/> HP <input type="checkbox"/> Volts <input type="checkbox"/>	Length of drop pipe <input type="checkbox"/> ft. capacity <input type="checkbox"/> g.p.m.				
Type: <input type="checkbox"/> Submersible <input type="checkbox"/> Turbine	<input type="checkbox"/> Jet <input type="checkbox"/> Reciprocating				
<input type="checkbox"/> Centrifugal <input type="checkbox"/> Other					
18. Elevation:	19. Remarks:				
Topography: <input type="checkbox"/> Hill <input type="checkbox"/> Slope <input type="checkbox"/> Upland <input checked="" type="checkbox"/> Valley	Bailer run 100 gal in 16 hrs.				
20. Water well contractor's certification: This well was drilled under my jurisdiction and this report is true to the best of my knowledge and belief. LAOD Drilling Co 358 Business name <input type="checkbox"/> License No. <input type="checkbox"/> Address Topeka, Ks Signed [Signature] Date 3/27/78 Authorized representative					

Forward the white, blue and pink copies to the Department of Health and Environment

Form WWC-5