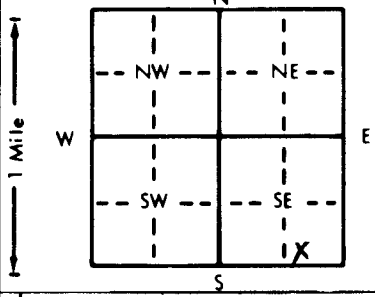


1 LOCATION OF WATER WELL: Fraction SW 1/4 SE 1/4 SE 1/4 Section Number 36 Township Number T 24 S Range Number R 13-14 E  
 County: WOODSON

Distance and direction from nearest town or city street address of well if located within city?  
3 miles NORTH 4 3/4 miles West NORTH SIDE RD from Yates Center, KS

2 WATER WELL OWNER: RALPH MENTZER  
 RR#, St. Address, Box #: RR 4 Board of Agriculture, Division of Water Resources  
 City, State, ZIP Code: Yates Center, KS Application Number:

3 LOCATE WELL'S LOCATION WITH AN "X" IN SECTION BOX:  
  
 4 DEPTH OF COMPLETED WELL: 70 ft. ELEVATION:  
 Depth(s) Groundwater Encountered 1. 32 ft. 2. ft. 3. ft.  
 WELL'S STATIC WATER LEVEL: 12 ft. below land surface measured on mo/day/yr 5/25/91  
 Pump test data: Well water was ft. after hours pumping gpm  
 Est. Yield 8 gpm: Well water was ft. after hours pumping gpm  
 Bore Hole Diameter: 7 in. to ft., and in. to ft.  
 WELL WATER TO BE USED AS:  
 1 Domestic  3 Feedlot  6 Oil field water supply  9 Dewatering  12 Other (Specify below)  
 2 Irrigation  4 Industrial  7 Lawn and garden only  10 Monitoring well  
 Was a chemical/bacteriological sample submitted to Department? Yes.....No.....; If yes, mo/day/yr sample was submitted  
 Water Well Disinfected? Yes  No

5 TYPE OF BLANK CASING USED:  
 1 Steel  3 RMP (SR)  6 Asbestos-Cement  9 Other (specify below)  Welded  
 2 PVC  4 ABS  7 Fiberglass  Threaded  
 Blank casing diameter 5 in. to ft., Dia. in. to ft., Dia. in. to ft.  
 Casing height above land surface 4 ft in., weight 50 R 26 lbs./ft. Wall thickness or gauge No. 5 DR 26  
 TYPE OF SCREEN OR PERFORATION MATERIAL:  
 1 Steel  3 Stainless steel  5 Fiberglass  7 PVC  10 Asbestos-cement  
 2 Brass  4 Galvanized steel  6 Concrete tile  9 ABS  11 Other (specify)  12 None used (open hole)  
 SCREEN OR PERFORATION OPENINGS ARE:  
 1 Continuous slot  3 Mill slot  5 Gauzed wrapped  8 Saw cut  11 None (open hole)  
 2 Louvered shutter  4 Key punched  6 Wire wrapped  9 Drilled holes  
 7 Torch cut  10 Other (specify)  
 SCREEN-PERFORATED INTERVALS: From 70 ft. to 50 ft., From ft. to ft., From ft. to ft.  
 GRAVEL PACK INTERVALS: From ft. to ft., From ft. to ft., From ft. to ft.

6 GROUT MATERIAL:  Neat cement  2 Cement grout  3 Bentonite  4 Other  
 Grout intervals: From 0 ft. to 20 ft., From ft. to ft., From ft. to ft.  
 What is the nearest source of possible contamination:  
 1 Septic tank  4 Lateral lines  7 Pit privy  10 Livestock pens  14 Abandoned water well  
 2 Sewer lines  5 Cess pool  8 Sewage lagoon  11 Fuel storage  15 Oil well/Gas well  
 3 Watertight sewer lines  6 Seepage pit  9 Feedyard  12 Fertilizer storage  16 Other (specify below)  
 13 Insecticide storage  
 Direction from well? West How many feet? 500 ft.

FROM	TO	LITHOLOGIC LOG	FROM	TO	PLUGGING INTERVALS
0	30	yellow clay			
30	32	blue shale			
32	60	WHITE WATER SAND			
60	70	GRAY SHALE			

7 CONTRACTOR'S OR LANDOWNER'S CERTIFICATION: This water well was (1) constructed, (2) reconstructed, or (3) plugged under my jurisdiction and was completed on (mo/day/year) 5/25/91 and this record is true to the best of my knowledge and belief. Kansas Water Well Contractor's License No. 501 This Water Well Record was completed on (mo/day/yr) 6-15-91 under the business name of Callien WATER Well SERVICE by (signature) Kenneth M Callien