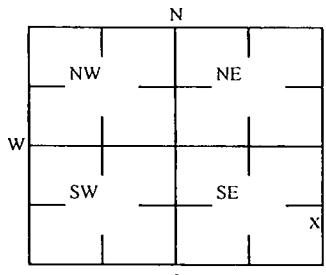


1 LOCATION OF WATER WELL: County: <u>Woodson</u>	Fraction SE ¼ NE ¼ SE ¼ SE ¼	Section Number 24	Township Number T 24 S	Range Number 16 <input checked="" type="checkbox"/> E <input type="checkbox"/> W
--	---------------------------------	----------------------	---------------------------	---

Street/Rural Address of Well Location; if unknown, distance & direction from nearest town or intersection: If at owner's address, check here <input type="checkbox"/> K-4 Hwy approximately 1 miles south of Meriden KS	Global Positioning Systems (GPS) information: Latitude: <u>NA</u> (in decimal degrees) Longitude: <u>NA</u> (in decimal degrees) Elevation: <u>NA</u> Horizontal Datum <input type="checkbox"/> WGS84, <input type="checkbox"/> NAD83, <input type="checkbox"/> NAD27 Collection Method: <input type="checkbox"/> GPS unit (Make/model: _____) <input type="checkbox"/> Digital Map/Photo, <input type="checkbox"/> Topographic Map <input type="checkbox"/> Land Survey Est. Accuracy: <input type="checkbox"/> <3 m, <input type="checkbox"/> 3-5 m, <input type="checkbox"/> 5-15 m, <input type="checkbox"/> >15 m
--	---


2 WATER WELL OWNER: RR#, St. Address, Box #: <u>Karl's K-Service</u> <u>4835 NE Kincaid</u> City, State ZIP Code: <u>Topeka, KS</u>	
---	--

3 MARK WELL'S LOCATION WITH AN "X" IN SECTION BOX: 	4 DEPTH OF WELL <u>10.5</u> ft. WELL'S STATIC WATER LEVEL <u>NA</u> ft WELL WAS USED AS: <table style="width: 100%;"> <tr> <td><input type="checkbox"/> Domestic</td> <td><input type="checkbox"/> Public Water Supply</td> <td><input type="checkbox"/> Dewatering</td> </tr> <tr> <td><input type="checkbox"/> Irrigation</td> <td><input type="checkbox"/> Oil Field Water Supply</td> <td><input checked="" type="checkbox"/> Monitoring</td> </tr> <tr> <td><input type="checkbox"/> Feedlot</td> <td><input type="checkbox"/> Domestic (Lawn & Garden)</td> <td><input type="checkbox"/> Injection Well</td> </tr> <tr> <td><input type="checkbox"/> Industrial</td> <td><input type="checkbox"/> Air Conditioning</td> <td><input type="checkbox"/> Other _____</td> </tr> </table> Was a chemical/bacteriological sample submitted to Department? Yes <input type="checkbox"/> No <input checked="" type="checkbox"/>	<input type="checkbox"/> Domestic	<input type="checkbox"/> Public Water Supply	<input type="checkbox"/> Dewatering	<input type="checkbox"/> Irrigation	<input type="checkbox"/> Oil Field Water Supply	<input checked="" type="checkbox"/> Monitoring	<input 

5 TYPE OF BLANK CASING USED: <input type="checkbox"/> Steel <input type="checkbox"/> RMP (SR) <input type="checkbox"/> Wrought <input type="checkbox"/> Fiberglass <input type="checkbox"/> Other (Specific below) <input checked="" type="checkbox"/> PVC <input type="checkbox"/> ABS <input type="checkbox"/> Asbestos-Cement <input type="checkbox"/> Concrete Tile	Blank casing diameter <u>2</u> in. Was casing pulled? Yes <input type="checkbox"/> No <input checked="" type="checkbox"/> If yes, how much <u>3'</u> Casing height above or below land surface <u>NA</u> in.
--	---

6 GROUT PLUG MATERIAL: <input type="checkbox"/> Neat cement <input type="checkbox"/> Cement grout <input checked="" type="checkbox"/> Bentonite <input checked="" type="checkbox"/> Other <u>Soil: 0-3'</u>	Grout Plug Intervals: From <u>3</u> ft to <u>10.5</u> ft, From _____ ft to _____ ft, From _____ ft to _____ ft. What is the nearest source of possible contamination: <table style="width: 100%;"> <tr> <td><input type="checkbox"/> Septic tank</td> <td><input type="checkbox"/> Seepage pit</td> <td><input type="checkbox"/> Fuel storage</td> <td><input type="checkbox"/> Other (specify below) _____</td> </tr> <tr> <td><input type="checkbox"/> Sewer lines</td> <td><input type="checkbox"/> Pit privy</td> <td><input type="checkbox"/> Fertilizer storage</td> <td></td> </tr> <tr> <td><input type="checkbox"/> Watertight sewer lines</td> <td><input type="checkbox"/> Sewage lagoon</td> <td><input type="checkbox"/> Insecticide storage</td> <td></td> </tr> <tr> <td><input type="checkbox"/> Lateral lines</td> <td><input type="checkbox"/> Feed yard</td> <td><input type="checkbox"/> Abandoned water well</td> <td>Direction from well? _____</td> </tr> <tr> <td><input type="checkbox"/> Cess pool</td> <td><input type="checkbox"/> Livestock pens</td> <td><input type="checkbox"/> Oil well/Gas well</td> <td>How many feet? _____</td> </tr>

FROM	TO	PLUGGING MATERIALS	FROM	TO	PLUGGING MATERIALS
0	3	Soil			
3	10.5	Bentonite			
KDHE ID: Karl's K-4 Service; U4-044-01746					

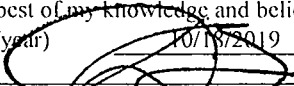7 CONTRACTOR'S OR LANDOWNER'S CERTIFICATION: completed on (mo/day/year) <u>10/17/2019</u> and this record is true to the best of my knowledge and belief. Kansas Water Contractor's License No. <u>757</u> . This Water Well Record was completed on (mo/day/year) <u>10/17/2019</u> under the business name of <u>Larsen & Associates, Inc.</u> By (signature) 	This water well was plugged under my jurisdiction and was completed on (mo/day/year) _____ and this record is true to the best of my knowledge and belief. Kansas Water Contractor's License No. _____ This Water Well Record was completed on (mo/day/year) _____ under the business name of _____ By (signature) _____
--	--

Send one white copy to Kansas Department of Health & Environment, Geology Section, 1000 SW Jackson Street, Ste. 420, Topeka, KS 66612-1367. Send one copy to WATER WELL OWNER and retain one for your records
 Visit us at <http://www.kdheks.gov/waterwell/index.html> Telephone 785-296-5524.