


1 LOCATION OF WATER WELL: County: Allen Fraction: SW 1/4 SW 1/4 SW 1/4 Section Number: 17 Township Number: T4P # 3 Range Number: R18 # 3

Distance and direction from nearest town or city street address of well if located within city?
201 South State Street Tola Ks

2 WATER WELL OWNER: Ken McGeer Refining Corp
 RR#, St. Address, Box #: PO Box 2367
 City, State, ZIP Code: Houston TX. 77253
 Board of Agriculture, Division of Water Resource
 Application Number:

3 LOCATE WELL'S LOCATION WITH AN "X" IN SECTION BOX:

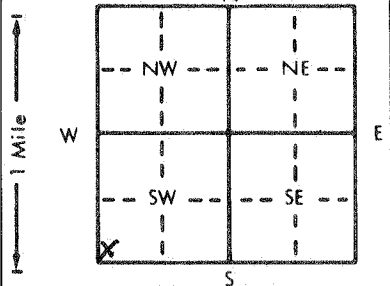

4 DEPTH OF COMPLETED WELL: 22.5 ft. ELEVATION: 98.69

Depth(s) Groundwater Encountered 1. 16.27 ft. 2. — ft. 3. — ft.
 WELL'S STATIC WATER LEVEL 16.27 ft. below land surface measured on mo/day/yr 9-22-93

Pump test data: Well water was — ft. after — hours pumping — gpm
 Est. Yield — gpm: Well water was — ft. after — hours pumping — gpm

Bore Hole Diameter: 8 in. to 22.5 ft., and — in. to — ft.
 WELL WATER TO BE USED AS:
 5 Public water supply 8 Air conditioning 11 Injection well
 1 Domestic 3 Feedlot 6 Oil field water supply 9 Dewatering 12 Other (Specify below)
 2 Irrigation 4 Industrial 7 Lawn and garden only 10 Monitoring well

Was a chemical/bacteriological sample submitted to Department? Yes — No ; If yes, mo/day/yr sample was submitted
 Water Well Disinfected? Yes — No

5 TYPE OF BLANK CASING USED:
 1 Steel 3 RMP (SR) 5 Wrought iron 8 Concrete tile CASING JOINTS: Glued — Clamped —
 2 PVC 4 ABS 6 Asbestos-Cement 9 Other (specify below) Welded —
 7 Fiberglass Threaded

Blank casing diameter: 2" in. to 12.5 ft., Dia — in. to — ft., Dia — in. to — ft.
 Casing height above land surface: 0.0 in., weight Sch 40 lbs./ft. Wall thickness or gauge No. —

TYPE OF SCREEN OR PERFORATION MATERIAL:
 1 Steel 3 Stainless steel 5 Fiberglass 8 RMP (SR) 10 Asbestos-cement
 2 Brass 4 Galvanized steel 6 Concrete tile 9 ABS 11 Other (specify) —
 12 None used (open hole)

SCREEN OR PERFORATION OPENINGS ARE:
 1 Continuous slot 3 Mill slot 5 Gauzed wrapped 8 Saw cut 11 None (open hole)
 2 Louvered shutter 4 Key punched 6 Wire wrapped 9 Drilled holes
 7 Torch cut 10 Other (specify) —

SCREEN-PERFORATED INTERVALS: From 12.5 ft. to 22.5 ft., From — ft. to — ft.
 From — ft. to — ft., From — ft. to — ft.

GRAVEL PACK INTERVALS: From — ft. to — ft., From — ft. to — ft.
 From 10.0 ft. to 22.5 ft., From — ft. to — ft.

6 GROUT MATERIAL: 1 Neat cement 2 Cement grout 3 Bentonite 4 Other —
 Grout Intervals: From 0.0 ft. to 10.0 ft., From — ft. to — ft., From — ft. to — ft.

What is the nearest source of possible contamination:
 1 Septic tank 4 Lateral lines 7 Pit privy 10 Livestock pens 14 Abandoned water well
 2 Sewer lines 5 Cess pool 8 Sewage lagoon 11 Fuel storage 15 Oil well/Gas well
 3 Watertight sewer lines 6 Seepage pit 9 Feedyard 12 Fertilizer storage 16 Other (specify below) N
 13 Insecticide storage

Direction from well? How many feet?

| FROM | TO | LITHOLOGIC LOG | FROM | TO | PLUGGING INTERVALS |
|------|------|------------------|------|----|--------------------|
| 0.0 | 0.5 | Concrete | | | |
| 0.5 | 3.2 | Clay DK Gr | | | |
| 3.2 | 13.0 | silty clay Gr Br | | | |
| 13.0 | 22.5 | silty clay Rd Br | | | |

7 CONTRACTOR'S OR LANDOWNER'S CERTIFICATION: This water well was (1) constructed, (2) reconstructed, or (3) plugged under my jurisdiction and was completed on (mo/day/year) 9-14-93 and this record is true to the best of my knowledge and belief. Kansas Water Well Contractor's License No. 416 This Water Well Record was completed on (mo/day/yr) 1-6-94 under the business name of Terracon Consultants Inc by (signature) Richard D Murphy

INSTRUCTIONS: Use typewriter or ball point pen. PLEASE PRESS FIRMLY and PRINT clearly. Please fill in blanks, underline or circle the correct answers. Send top three copies to Kansas Department of Health and Environment, Bureau of Water, Topeka, Kansas 66620-7320. Telephone: 913-296-5545. Send one to WATER WELL OWNER and retain one for your records.