

MW# 2


1 LOCATION OF WATER WELL: Fraction NE 1/4 NE 1/4 NE 1/4 Section Number 34 Township Number T 24 S Range Number R 18 EW

County: Allen Distance and direction from nearest town or city street address of well if located within city?  
110 South State St, ZOLA, KS

2 WATER WELL OWNER: TOWN & COUNTRY Board of Agriculture, Division of Water Resources  
RR#, St. Address, Box # P.O. BOX 17087 WICHITA, KANSAS 67217 Application Number:

3 LOCATE WELL'S LOCATION WITH AN "X" IN SECTION BOX:

4 DEPTH OF COMPLETED WELL: 25 ft. ELEVATION:

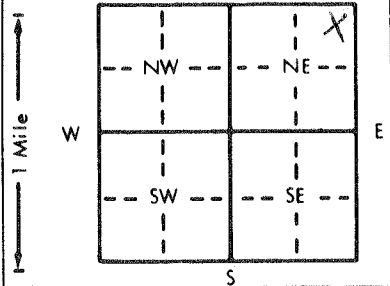

Depth(s) Groundwater Encountered 1. .... ft. 2. .... ft. 3. .... ft.  
WELL'S STATIC WATER LEVEL .17 ft. below land surface measured on mo/day/yr  
Pump test data: Well water was .... ft. after .... hours pumping .... gpm  
Est. Yield .... gpm; Well water was .... ft. after .... hours pumping .... gpm  
Bore Hole Diameter 7.14 in. to 23 ft., and .... in. to .... ft.  
WELL WATER TO BE USED AS: 5 Public water supply 8 Air conditioning 11 Injection well  
1 Domestic 3 Feedlot 6 Oil field water supply 9 Dewatering 12 Other (Specify below)  
2 Irrigation 4 Industrial 7 Lawn and garden only  Monitoring well  
Was a chemical/bacteriological sample submitted to Department? Yes.....No.....; If yes, mo/day/yr sample was submitted  
Water Well Disinfected? Yes No

5 TYPE OF BLANK CASING USED: 5 Wrought iron 8 Concrete tile CASING JOINTS: Glued ..... Clamped .....  
1 Steel 3 RMP (SR) 6 Asbestos-Cement 9 Other (specify below) Welded .....  
 PVC 4 ABS 7 Fiberglass ..... Threaded

Blank casing diameter 2 in. to 13 ft., Dia ..... in. to ..... ft., Dia ..... in. to ..... ft.  
Casing height above land surface 0 in., weight Sched 40 lbs./ft. Wall thickness or gauge No. ....

TYPE OF SCREEN OR PERFORATION MATERIAL:  PVC 10 Asbestos-cement  
1 Steel 3 Stainless steel 5 Fiberglass 8 RMP (SR) 11 Other (specify) .....  
2 Brass 4 Galvanized steel 6 Concrete tile 9 ABS 12 None used (open hole)

SCREEN OR PERFORATION OPENINGS ARE: 5 Gauzed wrapped 8 Saw cut 11 None (open hole)  
1 Continuous slot  Mill slot 6 Wire wrapped 9 Drilled holes  
2 Louvered shutter 4 Key punched 7 Torch cut 10 Other (specify) .....

SCREEN-PERFORATED INTERVALS: From 23 ft. to 13 ft., From ..... ft. to ..... ft.  
GRAVEL PACK INTERVALS: From 23 ft. to 11 ft., From ..... ft. to ..... ft.

6 GROUT MATERIAL: 1 Neat cement  Cement grout  Bentonite 4 Other .....  
Grout Intervals: From 9 ft. to 6 ft., From 11 ft. to 9 ft., From ..... ft. to ..... ft.

What is the nearest source of possible contamination:  
1 Septic tank 4 Lateral lines 7 Pit privy  Fuel storage 10 Livestock pens 14 Abandoned water well  
2 Sewer lines 5 Cess pool 8 Sewage lagoon 12 Fertilizer storage 15 Oil well/Gas well  
3 Watertight sewer lines 6 Seepage pit 9 Feedyard 13 Insecticide storage 16 Other (specify below)

Direction from well? South How many feet? 40'

FROM	TO	LITHOLOGIC LOG	FROM	TO	PLUGGING INTERVALS
0	1	TOPSOIL			
1	3	FAT CLAY, BROWN			
3	6.5	SILTY CLAY, GRAY, TAN			
6.5	9.5	SILTY LEAN TO FAT CLAY, TAN TO GRAY			
9.5	11	COBBLES W/CLAY, TAN			
11	14.5	CLAYEY SAND			
14.5	23	CLAYEY SAND, MOIST			

7 CONTRACTOR'S OR LANDOWNER'S CERTIFICATION: This water well was  constructed, (2) reconstructed, or (3) plugged under my jurisdiction and was completed on (mo/day/year) 7-17-95 and this record is true to the best of my knowledge and belief. Kansas Water Well Contractor's License No. 575 This Water Well Record was completed on (mo/day/yr) 8-7-95 under the business name of KWZ ENVIRONMENTAL SERVICE by (signature) [Signature]