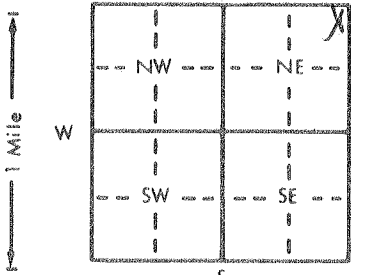


1 LOCATION OF WATER WELL: County: <u>Allen</u>	Fraction <u>NE</u> $\frac{1}{4}$ <u>NE</u> $\frac{1}{4}$ <u>NE</u> $\frac{1}{4}$	Section Number <u>34</u>	Township Number T <u>24</u> S	Range Number R <u>18</u> <u>E/W</u>
---	---	-----------------------------	----------------------------------	--

Distance and direction from nearest town or city street address of well if located within city?

100' South of State Street and Madison Street intersection, Iola, KS

2 WATER WELL OWNER: RR#, St. Address, Box # : <u>Kerr McGee Refining Corp</u> City, State, ZIP Code : <u>221 Norfolk, Ste 1100, PO Box 3367</u> <u>Houston, TX 77253</u>	Board of Agriculture, Division of Water Resource Application Number: <u>MW11</u>
---	---





SCREEN-PERFORATED INTERVALS: From <u>6.4</u> ft. to <u>21.4</u> ft., GRAVEL PACK INTERVALS: From <u>4</u> ft. to <u>21.9</u> ft., 

from well? <u>150</u> How many feet?
---	---

FROM	TO	LITHOLOGIC LOG	FROM	TO	PLUGGING INTERVALS
0	1.5	Topsoil			
1.5	11.5	Silty Clay			
11.5	16	Clayey Sand			
16	18	Gravel			
18	21.9	Clayey Sand			

7 CONTRACTOR'S OR LANDOWNER'S CERTIFICATION: This water well was (1) constructed, (2) reconstructed, or (3) plugged under my jurisdiction and was completed on (mo/day/year) <u>7/27/95</u> and this record is true to the best of my knowledge and belief. Kansas Water Well Contractor's License No. <u>102</u> This Water Well Record was completed on (mo/day/yr) <u>8-11-95</u> under the business name of <u>LAYNE-WESTERN Co.</u> by (signature) <u>[Signature]</u>
--