

LOCATION OF WATER WELL: Fraction TRACT 44A2 Section Number 22 Township Number T 24 S Range Number R 18 EW
 County: ALLEN

Distance and direction from nearest town or city street address of well if located within city?


North of Topeka 1 mile

WATER WELL OWNER: HAROLD ERBERT

RR#, St. Address, Box #: RR # 2
 City, State, ZIP Code: TOPEKA, KS.

Board of Agriculture, Division of Water Resource
 Application Number:

LOCATE WELL'S LOCATION WITH AN "X" IN SECTION BOX:

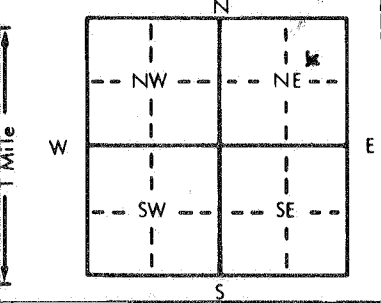

DEPTH OF COMPLETED WELL: 32 ft. ELEVATION:

Depth(s) Groundwater Encountered 1. 19 ft. 2. ft. 3. ft.

WELL'S STATIC WATER LEVEL 14 ft. below land surface measured on mo/day/yr 8-25-84

Pump test data: Well water was ft. after hours pumping gpm

Est. Yield 2 gpm; Well water was ft. after hours pumping gpm

Bore Hole Diameter: 9 5/8 in. to 32 ft., and in. to ft.

WELL WATER TO BE USED AS: 5 Public water supply 8 Air conditioning 11 Injection well

Domestic 3 Feedlot 6 Oil field water supply 9 Dewatering 12 Other (Specify below)

2 Irrigation 4 Industrial 7 Lawn and garden only 10 Observation well

Was a chemical/bacteriological sample submitted to Department? Yes No ; If yes, mo/day/yr sample was submitted 9/18/84 9-22-84

Water Well Disinfected? Yes No

TYPE OF BLANK CASING USED:

- 1 Steel
- 2 PVC
- 3 RMP (SR)
- 4 ABS
- 5 Wrought iron
- 6 Asbestos-Cement
- 7 Fiberglass
- 8 Concrete tile
- 9 Other (specify below)
- CASING JOINTS: Glued Clamped
- Welded
- Threaded

Blank casing diameter 6 in. to 32 ft., Dia in. to ft., Dia in. to ft.

Casing height above land surface 12 in., weight 2.2 lbs./ft. Wall thickness or gauge No. SCH. 40 6"

TYPE OF SCREEN OR PERFORATION MATERIAL:

- 1 Steel
- 2 Brass
- 3 Stainless steel
- 4 Galvanized steel
- 5 Fiberglass
- 6 Concrete tile
- 7 PVC
- 8 RMP (SR)
- 9 ABS
- 10 Asbestos-cement
- 11 Other (specify)
- 12 None used (open hole)

SCREEN OR PERFORATION OPENINGS ARE:

- 1 Continuous slot
- 2 Louvered shutter
- 3 Mill slot
- 4 Key punched
- 5 Gauzed wrapped
- 6 Wire wrapped
- 7 Torch cut
- 8 Saw cut
- 9 Drilled holes
- 10 Other (specify)
- 11 None (open hole)

SCREEN-PERFORATED INTERVALS: From 15 ft. to 32 ft., From ft. to ft., From ft. to ft., From ft. to ft.

GRAVEL PACK INTERVALS: From ft. to ft., From ft. to ft., From ft. to ft., From ft. to ft.

GROUT MATERIAL: Neat cement Cement grout Bentonite Other

Grout intervals: From 15 ft. to TOP ft., From ft. to ft., From ft. to ft., From ft. to ft.

- What is the nearest source of possible contamination:
- 1 Septic tank
 - 2 Sewer lines
 - 3 Watertight sewer lines
 - 4 Lateral lines
 - 5 Cess pool
 - 6 Seepage pit
 - 7 Pit privy
 - 8 Sewage lagoon
 - 9 Feedyard
 - 10 Livestock pens
 - 11 Fuel storage
 - 12 Fertilizer storage
 - 13 Insecticide storage
 - 14 Abandoned water well
 - 15 Oil well/Gas well
 - 16 Other (specify below)

Direction from well? NORTH How many feet? 2 miles

FROM	TO	LITHOLOGIC LOG	FROM	TO	LITHOLOGIC LOG
0'	4'	DIRT / Black to Brown			
4'	19'	CLAY / FINE SILTY			
19'	27'	GRAVEL + SAND - Brown Loose			
27'	32'	lime / BROWN + WHITE			
		<u>32' T.D.</u>			

CONTRACTOR'S OR LANDOWNER'S CERTIFICATION: This water well was constructed, (2) reconstructed, or (3) plugged under my jurisdiction and was completed on (mo/day/year) 8/25/84 and this record is true to the best of my knowledge and belief. Kansas Water Well Contractor's License No. 380 This Water Well Record was completed on (mo/day/yr) 9/17/84

under the business name of N+W Enterprises Inc. by (signature) [Signature]

INSTRUCTIONS: Use typewriter or ball point pen, PLEASE PRESS FIRMLY and PRINT clearly. Please fill in blanks, underline or circle the correct answers. Send top three copies to Kansas Department of Health and Environment, Division of Environment, Environmental Geology Section, Topeka, KS 66620. Send one to WATER WELL OWNER and retain one for your records.