


1] LOCATION OF WATER WELL: Fraction  $\frac{1}{4}$  NE  $\frac{1}{4}$  NE  $\frac{1}{4}$  Section Number 22 Township Number T 24 S Range Number R 18 EW  
 County: Allen

Distance and direction from nearest town or city street address of well if located within city?  
 NORTH of Tola Ks. 1 mile

2] WATER WELL OWNER: Wayne Barnett  
 RR#, St. Address, Box #: 2808 Dodge Dr.  
 City, State, ZIP Code: Tola, Kansas  
 Board of Agriculture, Division of Water Resources  
 Application Number:

3] LOCATE WELL'S LOCATION WITH AN "X" IN SECTION BOX:

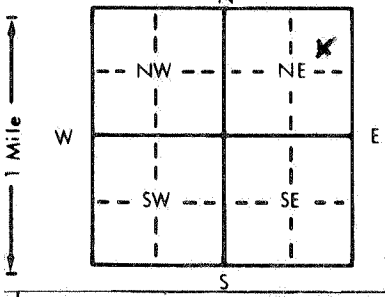

4] DEPTH OF COMPLETED WELL: 40 ft. ELEVATION:  
 Depth(s) Groundwater Encountered 1. 17 ft. 2. ft. 3. ft.  
 WELL'S STATIC WATER LEVEL 14 ft. below land surface measured on mo/day/yr 8-24-84  
 Pump test data: Well water was 19 ft. after 1 hours pumping 21 gpm  
 Est. Yield 21 gpm Well water was ft. after hours pumping gpm  
 Bore Hole Diameter 9 5/8 in. to 40 ft. and in. to ft.  
 WELL WATER TO BE USED AS:  
 Domestic 3 Feedlot 6 Oil field water supply 9 Dewatering 12 Other (Specify below)  
 2 Irrigation 4 Industrial 7 Lawn and garden only 10 Observation well  
 Was a chemical/bacteriological sample submitted to Department? Yes  No.....; If yes, mo/day/yr sample was submitted 9/18/84  
 Water Well Disinfected? Yes  No

5] TYPE OF BLANK CASING USED:  
 1 Steel 3 RMP (SR) 5 Wrought iron 8 Concrete tile CASING JOINTS: Glued  Clamped.....  
 2 PVC 4 ABS 6 Asbestos-Cement 9 Other (specify below) Welded.....  
 7 Fiberglass Threaded.....  
 Blank casing diameter 6 in. to 40 ft. Dia in. to ft. Dia in. to ft.  
 Casing height above land surface 12 in., weight 2.2 lbs./ft. Wall thickness or gauge No. SCH 40

TYPE OF SCREEN OR PERFORATION MATERIAL:  
 1 Steel 3 Stainless steel 5 Fiberglass 7 PVC 10 Asbestos-cement  
 2 Brass 4 Galvanized steel 6 Concrete tile 8 RMP (SR) 11 Other (specify)  
 12 None used (open hole)

SCREEN OR PERFORATION OPENINGS ARE:  
 1 Continuous slot 3 Mill slot 5 Gauzed wrapped 8 Saw cut 11 None (open hole)  
 2 Louvered shutter 4 Key punched 6 Wire wrapped 9 Drilled holes  
 7 Torch cut 10 Other (specify)

SCREEN-PERFORATED INTERVALS: From 15 ft. to Top 40 ft. From ft. to ft. ft.  
 From ft. to ft. From ft. to ft. ft.  
 GRAVEL PACK INTERVALS: From ft. to ft. From ft. to ft. ft.  
 From ft. to ft. From ft. to ft. ft.

6] GROUT MATERIAL:  1 Neat cement 2 Cement grout 3 Bentonite 4 Other  
 Grout intervals: From 15 ft. to Top ft. From ft. to ft. From ft. to ft. ft.  
 What is the nearest source of possible contamination:  
 1 Septic tank 4 Lateral lines 7 Pit privy 10 Livestock pens 14 Abandoned water well  
 2 Sewer lines 5 Cess pool 8 Sewage lagoon 11 Fuel storage  15 Oil well/Gas well  
 3 Watertight sewer lines 6 Seepage pit 9 Feedyard 12 Fertilizer storage 16 Other (specify below)  
 13 Insecticide storage

Direction from well? NORTH How many feet? 2 miles

FROM	TO	LITHOLOGIC LOG	FROM	TO	LITHOLOGIC LOG
0'	4'	DIRT / BROWN			
4'	17'	Clay / BROWN - SILTY FINE			
17'	25'	Gravel - Coarse / SANDY SILTY			
25'	28'	Lime / SANDY / WHITE			
28'	40'	Lime / BROWN + WHITE			
		40' T.D.			

7] CONTRACTOR'S OR LANDOWNER'S CERTIFICATION: This water well was  (1) constructed  (2) reconstructed, or  (3) plugged under my jurisdiction and was completed on (mo/day/year) 8/24/84 and this record is true to the best of my knowledge and belief. Kansas Water Well Contractor's License No. 380 This Water Well Record was completed on (mo/day/yr) 9/17/84 under the business name of NEW ENTERPRISES INC. by signature Thomas J. [Signature]

INSTRUCTIONS: Use typewriter or ball point pen, PLEASE PRESS FIRMLY and PRINT clearly. Please fill in blanks, underline or circle the correct answers. Send top three copies to Kansas Department of Health and Environment, Division of Environment, Environmental Geology Section, Topeka, KS 66620. Send one to WATER WELL OWNER and retain one for your records.