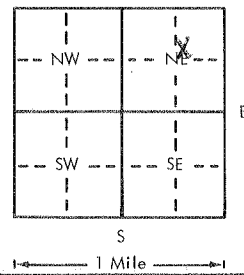
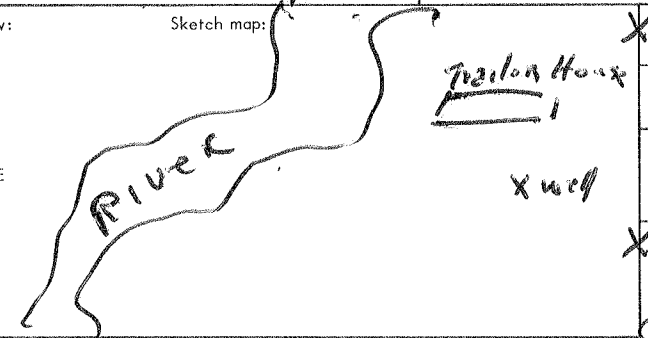


USE TYPEWRITER OR BALL
POINT PEN-PRESS FIRMLY,
PRINT CLEARLY.

WATER WELL RECORD
KSA 82a-1201-1215

Kansas Department of Health and
Environment-Division of Environment
(Water well Contractors)
Topeka, Kansas 66620

1. Location of well:	County <u>Allen</u>	Xraction <u>SW 1/4 NE 1/4 NE 1/4</u>	Section number <u>34</u>	Township number <u>T 24</u>	Range number <u>S R 18</u>
2. Distance and direction from nearest town or city:	<u>Topeka City Park Road West</u>		3. Owner of well: <u>Joe Scheil</u>		
Street address of well location if in city:	<u>To 50 yds River</u>		R.R. or street:	<u>720 East Briarway</u>	
			City, state, zip code:	<u>Topeka, Kans 66749</u>	
4. Locate with "X" in section below:	Sketch map:		X 6. Bore hole dia. <u>8 3/4</u> in. Completion date <u>8/18/78</u>		
			Well depth <u>55</u> ft.		
5. Type and color of material	From	To	7. ☒ Cable tool ☐ Rotary ☐ Driven ☐ Dug		
<u>Soil</u>	<u>0</u>	<u>5</u>	☐ Hollow rod ☐ Jetted ☐ Bored ☐ Reverse rotary		
<u>Clay, yellow</u>	<u>5</u>	<u>12</u>	8. Use: ☒ Domestic ☐ Public supply ☐ Industry		
<u>Shale Blue</u>	<u>12</u>	<u>20</u>	☐ Irrigation ☐ Air conditioning ☐ Stock		
<u>Clay - Silty Gravel</u>	<u>20</u>	<u>24</u>	☐ Lawn ☐ Oil field water ☐ Other		
<u>Small amt WTR</u>	<u>24</u>	<u>29</u>	9. Casing: Material <u>Galvanized Steel</u> Height: Above or below,		
<u>Increase WTR</u>	<u>29</u>	<u>31</u>	Threaded <u>Steel</u> Surface <u>12</u> in.		
	<u>31</u>	<u>41</u>	RMP <u>PVC</u> Weight <u>15</u> lbs./ft.		
	<u>41</u>	<u>56</u>	Dia. <u>8</u> in. to <u>55</u> ft. depth Wall Thickness: inches or		
			Dia. <u>55</u> in. to <u>55</u> ft. depth gage No. <u>55</u>		
			10. Screen: Manufacturer's name <u>Perforated Steel Galvanized</u>		
			Type <u>Pipe</u> Dia. <u>30</u>		
			Slot/gauge <u>30</u> Length <u>35</u>		
			Set between <u>30</u> ft. and <u>35</u> ft.		
			Gravel pack? <u>Yes</u> Size range of material <u>1/2 to 3/4</u>		
			11. Static water level: <u>8</u> ft. below land surface Date <u>8/18/78</u>		
			12. Pumping level below land surfaces:		
			<u>8</u> ft. after <u>0</u> hrs. pumping <u>0</u> g.p.m.		
			<u>8</u> ft. after <u>0</u> hrs. pumping <u>0</u> g.p.m.		
			Estimated maximum yield <u>0</u> g.p.m.		
			13. Water sample submitted: <u>Yes</u> ☒ No ☐ Date <u>8/18/78</u>		
			14. Well head completion:		
			☐ Pitless adapter ☐ Inches above grade		
			15. Well grouted? <u>Yes</u>		
			With: ☒ Neat cement ☐ Bentonite ☐ Concrete		
			Depth: From <u>0</u> ft. to <u>10</u> ft.		
			16. Nearest source of possible contamination:		
			ft. <u>75</u> Direction <u>NN</u> Type <u>Septic</u>		
			Well disinfected upon completion? ☒ Yes ☐ No		
			17. Pump: ☒ Not installed		
			Manufacturer's name <u>Eureka Well Service</u>		
			Model number <u>296</u> HP <u>1/4</u> Volts <u>115</u>		
			Length of drop pipe <u>0</u> ft. capacity <u>0</u> g.p.m.		
			Type:		
			☐ Submersible ☐ Turbine		
			☐ Jet ☐ Reciprocating		
			☐ Centrifugal ☐ Other		
18. Elevation:	19. Remarks: <u>Drilled 8 3/4 Bit - Hole wallered</u>		20. Water well contractor's certification:		
Topography:	<u>River Bottom</u>		This well was drilled under my jurisdiction and this report		
☐ Hill			is true to the best of my knowledge and belief.		
☐ Slope			Business name <u>Eureka Well Service</u> License No. <u>296</u>		
☐ Upland			Address <u>225 Walnut Eureka, Kans</u>		
☐ Valley			Signed <u>James Ashlock</u> Date <u>8-18-78</u>		
			Authorized representative		

Forward the white, blue and pink copies to the Department of Health and Environment

Form WWC-5