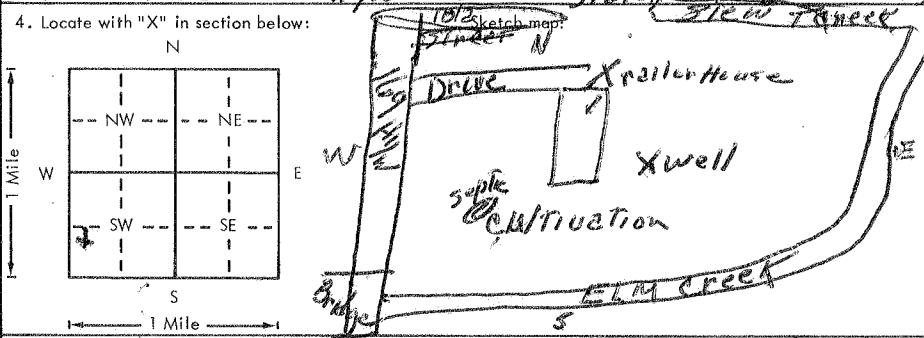


USE TYPEWRITER OR BALL
POINT PEN-PRESS FIRMLY,
PRINT CLEARLY.

WATER WELL RECORD
KSA 82a-1201-1215

Kansas Department of Health and
Environment-Division of Environment
(Water well Contractors)
Topeka, Kansas 66620

1. Location of well:		County: <u>Allen</u>	Fraction: <u>NW 1/4 SW 1/4 SW 1/4</u>	Section number: <u>35</u>	Township number: <u>T 24 S</u>	Range number: <u>R 18 E/W</u>
2. Distance and direction from nearest town or city:		<u>1/2 mile south Iola, KS</u>		3. Owner of well: <u>Jim Easter</u> Phone: <u>316-365-5544</u>		
Street address of well location if in city:		<u>EAST side of Hwy #169 - 1201 South State</u>		R.R. or street: <u>1201 South State</u>		
4. Locate with "X" in section below:		City, state, zip code: <u>Iola Kansas 66749</u>		6. Bore hole dia. <u>8 1/4</u> in. Completion date <u>4/27/19</u>		
		Well depth <u>79</u> ft.		7. Cable tool ☒ Rotary ☐ Driven ☐ Dug ☐ Hollow rod ☐ Jetted ☐ Bored ☐ Reverse rotary		
		8. Use: ☒ Domestic ☐ Public supply ☐ Industry ☐ Irrigation ☐ Air conditioning ☐ Stock ☐ Lawn ☐ Oil field water ☐ Other				
5. Type and color of material		From		To		9. Casing: Material <u>STEEL</u> Height: Above or below
						Threaded ☐ Welded ☐ Surface <u>12</u> in.
						RMP ☐ PVC <u>A</u> Weight ☐ lbs./ft.
						Dia. <u>6</u> in. to <u>19</u> ft. depth Wall Thickness: inches or
						Dia. ☐ in. to ☐ ft. depth gage No. <u>255</u>
						10. Screen: Manufacturer's name <u>Reticon PVC</u>
						Type ☐ Dia. <u>6</u>
						Slot/gauze <u>030</u> Length <u>3</u> ft.
						Set between <u>19</u> ft. and <u>79</u> ft.
						Gravel pack? ☒ Size range of material <u>1/16 to 3/4</u> in.
						11. Static water level: <u>8</u> ft. below land surface Date <u>4/27/19</u>
						12. Pumping level below land surface: <u>Not Test</u>
						ft. after <u>Not Test</u> pumping <u>Not Test</u> g.p.m.
						ft. after <u>Not Test</u> hrs. pumping <u>Not Test</u> g.p.m.
						Estimated maximum yield <u>1 1/2</u> g.p.m.
						13. Water sample submitted: <u>Yes</u> ☒ No ☐ Date <u>4/27/19</u>
						14. Well head completion: <u>12</u> inches above grade
						<u>Pitless adapter</u>
						15. Well grouted? <u>Yes</u>
						With: ☒ Neat cement ☐ Bentonite ☐ Concrete
						Depth: From <u>0</u> ft. to <u>10</u> ft.
						16. Nearest source of possible contamination: <u>Septic</u>
						ft. <u>60</u> Direction <u>SW</u> Type <u>Septic</u>
						Well disinfected upon completion? ☒ Yes ☐ No
						17. Pump: ☒ Not installed
						Manufacturer's name <u>Nichols Well Dels</u>
						Model number <u>377</u> HP <u>1/4</u> Volts <u>115</u>
						Length of drop pipe <u>45</u> ft. capacity <u>1/4</u> g.p.m.
						Type: ☐ Submersible ☐ Turbine ☐ Jet ☐ Reciprocating ☐ Centrifugal ☐ Other
18. Elevation:		19. Remarks:		20. Water well contractor's certification:		
Topography: <u>Hill</u>		<u>Well Drilled on High Point Bottom Land</u>		This well was drilled under my jurisdiction and this report is true to the best of my knowledge and belief.		
<u>Slope</u>				Business name <u>Nichols Well Dels</u> License No. <u>377</u>		
<u>Upland</u>				Address <u>Rte 45 Liberal MO</u>		
<u>Valley</u>				Signed <u>[Signature]</u> Date <u>5/5/19</u>		

Forward the white, blue and pink copies to the Department of Health and Environment

Form WWC-5