

1	LOCATION OF WATER WELL:	Fraction	Section Number	Township Number	Range Number
County:	<i>Allen</i>	<i>SW 1/4 SE 1/4 NE 1/4</i>	<i>27</i>	T <i>24</i> S	R <i>18</i> <i>EW</i>

Distance and direction from nearest town or city street address of well if located within city?





Board of Agriculture, Division of Water Resources  
Application Number:

3 LOCATE WELL'S LOCATION WITH AN "X" IN SECTION BOX:

4 DEPTH OF COMPLETED WELL ..... 15 ..... ft. ELEVATION: 959.79 .....

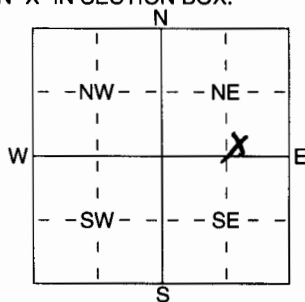

Depth(s) Groundwater Encountered 1 ..... ft. 2 ..... ft. 3 ..... ft.  
WELL'S STATIC WATER LEVEL 4.57 ..... ft. below land surface measured on mo/day/yr 7/22/04

Pump test data: Well water was ..... ft. after ..... hours pumping ..... gpm  
 Est. Yield ..... gpm: Well water was ..... ft. after ..... hours pumping ..... gpm

Est. Yield ..... gpm: Well water was ..... ft. after ..... hours pumping ..... gpm

WELL WATER TO BE USED AS:    5 Public water supply                      8 Air conditioning                      11 Injection well

1 Domestic      3 Feedlot      6 Oil field water supply      9 Dewatering      12 Other (Specify below)  
2 Irrigation      4 Industrial      7 Domestic (lawn & garden)      10 Monitoring well      MW-6

Was a chemical/bacteriological sample submitted to Department? Yes ..... No X ..... ; If yes, mo/day/ yrs sample was submitted  
Water Well Disinfected? Yes ..... No X .....

5	TYPE OF BLANK CASING USED:
---	----------------------------

1 Steel  
2 PVC  
3 RMP (SR)  
4 ABS

5 Wrought iron  
6 Asbestos-Cement  
7 Fiberglass

8 Concrete tile  
9 Other (specify below)

CASING JOINTS: Glued ..... Clamped .....

Welded .....  
Threaded .....

Blank casing diameter ..... 2 ..... in. to 5 ..... ft., Dia ..... in. to ..... ft., Dia ..... in. to ..... ft.

Casing height above land surface Flush in., weight 5 chd 40 lbs./ft. Wall thickness or gauge No. ....

TYPE OF SCREEN OR PERFORATION MATERIAL:

1 Steel	3 Stainless Steel
2 Brass	4 Galvanized Steel

5 Fiberglass  
6 Concrete tile

7 PVC  
8 RMP (SR)  
9 ABS

10 Asbestos-Cement  
11 Other (Specify) .....  
12 None used (open hole)

SCREEN OR PERFORATION OPENINGS ARE:

1 Continuous slot      3 Mill slot  
2 Louvered shutter    4 Key punched

5 Guazed wrapped  
6 Wire wrapped  
7 Torch cut

8 Saw cut  
9 Drilled holes  
10 Other (specify) ..... ft.  
11 None (open hole)

SCREEN-PERFORATED INTERVALS: From 5 ft. to 15 ft., From \_\_\_\_\_ ft. to \_\_\_\_\_ ft.

GRAVEL PACK INTERVALS: From 3 ft. to 15 ft. From ft. to ft. From ft. to ft. From ft. to ft.

6 GROUT MATERIAL: 1 Neat cement 2 Cement grout 3 Bentonite 4 Other .....

Grout Intervals: From 1 ft. to 3 ft. From \_\_\_\_\_ ft. to \_\_\_\_\_ ft. From \_\_\_\_\_ ft. to \_\_\_\_\_ ft.

**What is the nearest source of possible contamination:**

1 Septic tank	4 Lateral lines
2 Sewer lines	5 Cess pool
3 Watertight sewer lines	6 Seepage pit

7 Pit privy  
8 Sewage lagoon  
9 Feedyard

10 Livestock pens 14 Abandoned water well  
11 Fuel storage 15 Oil well/Gas well  
12 Fertilizer storage 16 Other (specify below)  
13 Insecticide storage Contaminated S.T.

Direction from well?

How many feet?

[illegible]

7] CONTRACTOR'S OR LANDOWNER'S CERTIFICATION: This water well was (1) constructed, (2) reconstructed, or (3) plugged under my jurisdiction and was completed on (mo/day/year) ..... 7/16/24 ..... and this record is true to the best of my knowledge and belief. Kansas

Water Well Contractor's Licence No. 204 This Water Well Record was completed on (mo/day/y) 2/3/84  
under the business name of M&S by (signature) Donna Hume

INSTRUCTIONS: Use typewriter or ball point pen. PLEASE PRESS FIRMLY and PRINT clearly. Please fill in blanks, underline or circle the correct answers. Send top three copies to Kansas Department of Health and Environment, Bureau of Water, Geology Section, 1000 SW Jackson St., Suite 420, Topeka, Kansas 66612-1367. Telephone 785-296-5522. Send one to WATER WELL OWNER and retain one for your records. Fee of \$5.00 for each constructed well.