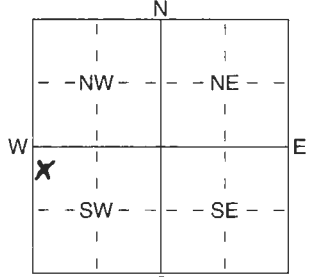


1 LOCATION OF WATER WELL: Fraction SW 1/4 NW 1/4 NW 1/4 SW Section Number 26 Township Number T 24 S Range Number R 18 EW
 County: Allen

Distance and direction from nearest town or city street address of well if located within city?
601 North State Street ToLa, KS 66749

2 WATER WELL OWNER: Sigg Brothers
 RR#, St. Address, Box # :
 City, State, ZIP Code : 601 North State Street ToLa, KS 66749
 Board of Agriculture, Division of Water Resources
 Application Number:

3 LOCATE WELL'S LOCATION WITH AN "X" IN SECTION BOX:

 4 DEPTH OF COMPLETED WELL 14.80 ft. ELEVATION: 960.48
 Depth(s) Groundwater Encountered 1 2.98 ft. 2 2.96 ft. 3 _____ ft.
 WELL'S STATIC WATER LEVEL 957.52 ft. below land surface measured on mo/day/yr 1/11/05
 Pump test data: Well water was _____ ft. after _____ hours pumping _____ gpm
 Est. Yield _____ gpm: Well water was _____ ft. after _____ hours pumping _____ gpm
 WELL WATER TO BE USED AS:
 1 Domestic 3 Feedlot 6 Oil field water supply 8 Air conditioning 11 Injection well
 2 Irrigation 4 Industrial 7 Domestic (lawn & garden) Monitoring well MW-01
 12 Other (Specify below)
 Was a chemical/bacteriological sample submitted to Department? Yes _____ No ; If yes, mo/day/yr sample was submitted
 Water Well Disinfected? Yes _____ No

5 TYPE OF BLANK CASING USED:
 1 Steel 3 RMP (SR) 5 Wrought iron 8 Concrete tile CASING JOINTS: Glued _____ Clamped _____
 PVC 4 ABS 7 Fiberglass _____ Welded _____
 Blank casing diameter 2 in. to _____ ft., Dia _____ in. to _____ ft., Dia _____ in. to _____ ft.
 Casing height above land surface -0.49 in., weight _____ lbs./ft. Wall thickness or gauge No. sch 40
 TYPE OF SCREEN OR PERFORATION MATERIAL:
 1 Steel 3 Stainless Steel 5 Fiberglass PVC 10 Asbestos-Cement
 2 Brass 4 Galvanized Steel 6 Concrete tile 8 RMP (SR) 11 Other (Specify) _____
 9 ABS 12 None used (open hole)
 SCREEN OR PERFORATION OPENINGS ARE:
 1 Continuous slot Mill slot 5 Gauzed wrapped 8 Saw cut 11 None (open hole)
 2 Louvered shutter 4 Key punched 6 Wire wrapped 9 Drilled holes
 7 Torch cut 10 Other (specify) _____ ft.
 SCREEN-PERFORATED INTERVALS: From 4.8 ft. to 14.8 ft., From _____ ft. to _____ ft.
 GRAVEL PACK INTERVALS: From 3.0 ft. to 14.8 ft., From _____ ft. to _____ ft.

6 GROUT MATERIAL: 1 Neat cement 2 Cement grout Bentonite 4 Other _____
 Grout Intervals: From 1 ft. to 3 ft., From _____ ft. to _____ ft., From _____ ft. to _____ ft.
 What is the nearest source of possible contamination:
 1 Septic tank 4 Lateral lines 7 Pit privy Fuel storage 14 Abandoned water well
 2 Sewer lines 5 Cess pool 8 Sewage lagoon 12 Fertilizer storage 15 Oil well/Gas well
 3 Watertight sewer lines 6 Seepage pit 9 Feedyard 13 Insecticide storage 16 Other (specify below)
 Direction from well? South How many feet? 5ft

FROM	TO	LITHOLOGIC LOG	FROM	TO	PLUGGING INTERVALS
1	3	med to high plastic clay, dk br stiff strong odor			
7	9	high plastic clay, tr FeO ₂ , stiff, strong odor, gray			
10	12	high plastic clay, gray to dark gray, tr FeO ₂ , sat'd zone, slight odor			

7 CONTRACTOR'S OR LANDOWNER'S CERTIFICATION: This water well was constructed, (2) reconstructed, or (3) plugged under my jurisdiction and was completed on (mo/day/year) 1/31/05 and this record is true to the best of my knowledge and belief. Kansas Water Well Contractor's Licence No 704 This Water Well Record was completed on (mo/day/yr) 1/14/05 under the business name of mas by (signature) [Signature]