

MW12


WATER WELL RECORD Form WWC-5 KSA 82a-1212

1 LOCATION OF WATER WELL: Fraction NE 1/4 NE 1/4 SE 1/4 Section Number 27 Township Number T 24 S Range Number R 18 E
 County: ALLEN

Distance and direction from nearest town or city street address of well if located within city?
612 N State St. Iola, KS

2 WATER WELL OWNER: CARDERS PHARMART
 RR#, St. Address, Box #: 1020 W Sycamore Board of Agriculture, Division of Water Resources
 City, State, ZIP Code: INDEPENDENCE, KS 67301 Application Number:

3 LOCATE WELL'S LOCATION WITH AN "X" IN SECTION BOX:

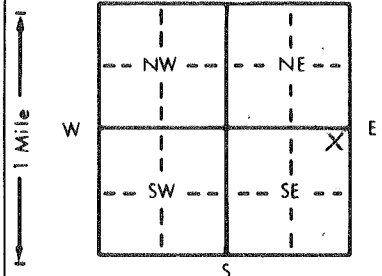

4 DEPTH OF COMPLETED WELL: 15.5 ft. ELEVATION: -
 Depth(s) Groundwater Encountered 1. ~10-10.5 ft. 2. - ft. 3. - ft.
 WELL'S STATIC WATER LEVEL 5.67 ft. below land surface measured on mo/day/yr 4/16/98
 Pump test data: Well water was - ft. after - hours pumping - gpm
 Est. Yield - gpm: Well water was - ft. after - hours pumping - gpm
 Bore Hole Diameter: 8.5 in. to 15.5 ft., and - in. to - ft.
 WELL WATER TO BE USED AS:
 5 Public water supply 8 Air conditioning 11 Injection well
 1 Domestic 3 Feedlot 6 Oil field water supply 9 Dewatering 12 Other (Specify below)
 2 Irrigation 4 Industrial 7 Lawn and garden only Monitoring well MW-12
 Was a chemical/bacteriological sample submitted to Department? Yes - No ; If yes, mo/day/yr sample was submitted
 Water Well Disinfected? Yes - No

5 TYPE OF BLANK CASING USED:
 1 Steel 3 RMP (SR) 5 Wrought iron 8 Concrete tile CASING JOINTS: Glued - Clamped -
 2 PVC 4 ABS 6 Asbestos-Cement 9 Other (specify below) Welded -
 7 Fiberglass Threaded

Blank casing diameter 2 in. to 5.5 ft. Dia - in. to - ft. Dia - in. to - ft.
 Casing height above land surface 0 in., weight SCH 40 lbs./ft. Wall thickness or gauge No. -

TYPE OF SCREEN OR PERFORATION MATERIAL:
 1 Steel 3 Stainless steel 5 Fiberglass 8 RMP (SR) 10 Asbestos-cement
 2 Brass 4 Galvanized steel 6 Concrete tile 9 ABS 11 Other (specify) 7 PVC
 12 None used (open hole)

SCREEN OR PERFORATION OPENINGS ARE:
 1 Continuous slot 3 Mill slot 5 Gauzed wrapped 8 Saw cut 11 None (open hole)
 2 Louvered shutter 4 Key punched 6 Wire wrapped 9 Drilled holes
 7 Torch cut 10 Other (specify) -

SCREEN-PERFORATED INTERVALS: From 5.5 ft. to 15.5 ft., From - ft. to - ft.
 From - ft. to - ft., From - ft. to - ft.
 SAND
 GRAVEL PACK INTERVALS: From 4 ft. to 15.5 ft., From - ft. to - ft.
 From - ft. to - ft., From - ft. to - ft.

6 GROUT MATERIAL: 1 Neat cement 2 Cement grout 3 Bentonite 4 Other
 Grout Intervals: From 0 ft. to 2 ft., From 2 ft. to 4 ft., From - ft. to - ft.

What is the nearest source of possible contamination:
 1 Septic tank 4 Lateral lines 7 Pit privy 10 Livestock pens 14 Abandoned water well
 2 Sewer lines 5 Cess pool 8 Sewage lagoon 11 Fuel storage 15 Oil well/Gas well
 3 Watertight sewer lines 6 Seepage pit 9 Feedyard 12 Fertilizer storage 16 Other (specify below) contaminated site
 13 Insecticide storage

Direction from well? How many feet?

FROM	TO	LITHOLOGIC LOG	FROM	TO	PLUGGING INTERVALS
0	1	SOIL / GRAVEL MIX			
1	4	CLAY w/ SILT (CL)			
4	15	CLAYEY SILT (ML)			
15	TD	END OF BOREHOLE			

7 CONTRACTOR'S OR LANDOWNER'S CERTIFICATION: This water well was constructed, reconstructed, or plugged under my jurisdiction and was completed on (mo/day/year) 4/16/98 and this record is true to the best of my knowledge and belief. Kansas Water Well Contractor's License No. 585 This Water Well Record was completed on (mo/day/yr) 4/17/98 under the business name of A21 by (signature) Abuncan for Matt Drake