

WATER WELL RECORD

Form WWC-5

Division of Water Resources App. No.


Well ID

MW6

[X] Original Record [ ] Correction [ ] Change in Well Use

1 LOCATION OF WATER WELL: County Allen Fraction NW 1/4 NE 1/4 NW 1/4 NW 1/4 Section Number 36 Township Number T 24 S Range Number R 18 E [X] [ ] W

2 WELL OWNER: Last Name: Business: KDHE (L & S Motors) Address: 1000 SW Jackson City: Topeka State: KS ZIP: 66612 Street or Rural Address where well is located (if unknown, distance and direction from nearest town or intersection): 1401 East St, Iola, KS 66749

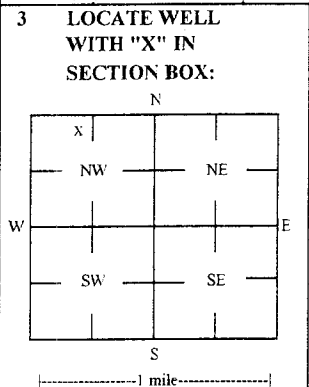

3 LOCATE WELL WITH 'X' IN SECTION BOX: 4 DEPTH OF COMPLETED WELL: 16.95 ft Depth(s) Groundwater Encountered: 1) \_\_\_\_\_ ft 2) \_\_\_\_\_ ft 3) \_\_\_\_\_ ft, or 4) [ ] Dry Well WELL'S STATIC WATER LEVEL: 2.08 ft [X] below land surface, measured on (mo-day-yr) 11/18/15 [ ] above land surface, measured on (mo-day-yr) Pump test data: Well water was \_\_\_\_\_ ft after \_\_\_\_\_ hours pumping \_\_\_\_\_ gpm Water well was \_\_\_\_\_ ft after \_\_\_\_\_ hours pumping \_\_\_\_\_ gpm Estimated Yield: \_\_\_\_\_ gpm Bore Hole Diameter: 7.25 in to \_\_\_\_\_ ft, and \_\_\_\_\_ in to \_\_\_\_\_ ft

5 Latitude: 37.92200 (decimal degrees) Longitude: 95.38811 (decimal degrees) Horizontal Datum: [X] WGS 84 [ ] NAD 83 [ ] NAD 27 Source for Latitude/Longitude: [ ] GPS (unit make/model: \_\_\_\_\_) (WAAS enabled? [ ] Yes [ ] No) [X] Land Survey [ ] Topographic Map [ ] Online Mapper 6 Elevation: 961.78 ft [ ] Ground Level [X] TOC Source: [X] Land Survey [ ] GPS [ ] Topographic Map [ ] Other \_\_\_\_\_

7 WELL WATER TO BE USED AS: 1 Domestic: [ ] Household [ ] Lawn & Garden [ ] Livestock [ ] Irrigation [ ] Feedlot [ ] Industrial 2 Public Water Supply: well ID 3 Dewatering: how many wells? 4 Aquifer Recharge: well ID 5 Monitoring: well ID MW6 6 Environmental Remediation: well ID 7 Air Sparge [ ] Soil Vapor Extractor [ ] Recovery [ ] Injection 8 Oil Field Water Supply: lease 9 Test Hole: well ID [ ] Cased [ ] Uncased [ ] Geotechnical 10 Geothermal: How many bores? a) Closed Loop [ ] Horizontal [ ] Vertical b) Open Loop [ ] Surface Discharge [ ] Inj. of Water [ ] Other (specify): \_\_\_\_\_

Was a chemical/bacteriological sample submitted to KDHE? [ ] Yes [X] No If yes, date sample was submitted: \_\_\_\_\_ Water well disinfected? [ ] Yes [X] No

8 TYPE OF CASING USED: [ ] Steel [X] PVC [ ] Other CASING JOINTS: [ ] Glued [ ] Clamped [ ] Welded [X] Threaded Casing diameter 2 in. to 3 ft, Diameter \_\_\_\_\_ in. to \_\_\_\_\_ ft, Diameter \_\_\_\_\_ in. to \_\_\_\_\_ ft, Casing height above land surface -0.41 in. Weight \_\_\_\_\_ lbs./ft. Well thickness or gauge No \_\_\_\_\_ TYPE OF SCREEN OR PERFORATION MATERIAL: [ ] Steel [ ] Stainless Steel [ ] Fiberglass [X] PVC [ ] Brass [ ] Galvanized Steel [ ] Concrete tile [ ] None used (open hole) [ ] Other (Specify) \_\_\_\_\_ SCREEN OR PERFORATION OPENINGS ARE: [ ] Continuous Slot [X] Mill Slot [ ] Gauze Wrapped [ ] Torch Cut [ ] Drilled Holes [ ] Other (Specify) [ ] Louvered Shutter [ ] Key Punched [ ] Wire Wrapped [ ] Saw Cut [ ] None (Open Hole) SCREEN-PERFORATED INTERVALS: From 3 ft. to 16.95 ft, From \_\_\_\_\_ ft. to \_\_\_\_\_ ft, From \_\_\_\_\_ ft. to \_\_\_\_\_ ft, GRAVEL PACK INTERVALS: From 2 ft. to 17.5 ft, From \_\_\_\_\_ ft. to \_\_\_\_\_ ft, From \_\_\_\_\_ ft. to \_\_\_\_\_ ft,

9 GROUT MATERIAL: [ ] Neat cement [ ] Cement grout [X] Bentonite [X] Other Concrete: 0-1' Grout intervals: From 1 ft. to 2 ft, From \_\_\_\_\_ ft. to \_\_\_\_\_ ft, From \_\_\_\_\_ ft. to \_\_\_\_\_ ft,

Nearest source of possible contamination: [ ] Septic Tank [ ] Lateral Lines [ ] Pit Privy [ ] Livestock Pens [ ] Insecticide Storage [ ] Sewer Lines [ ] Cess Pool [ ] Sewage Lagoon [X] Fuel Storage [ ] Abandoned Water Well [ ] Watertight Sewer Lines [ ] Seepage Pit [ ] Feedyard [ ] Fertilizer Storage [ ] Oil Well / Gas Well [ ] Other (Specify) \_\_\_\_\_ Direction from well? W Distance from well? ~150 ft

Table with 6 columns: FROM, TO, LITHOLOGIC LOG, FROM, TO, LITHO. LOG (cont.) or PLUGGING INTERVALS. Rows: 0-2 Gravel, 2-17 Silty clay, 17-17.5 Limestone

Notes: KDHE ID: L & S Motors: U3-001-14807

11 CONTRACTOR'S OR LANDOWNER'S CERTIFICATION: This water well was [X] constructed, [ ] reconstructed, or [ ] plugged under my jurisdiction and was completed on (mo-day-year) 11/18/15 and this record is true to the best of my knowledge and belief. Kansas Water Well Contractor's License No 757 This Water Well Record was completed on (mo-day-year) 1/28/16 under the business name of Larsen & Associates, Inc. Signature \_\_\_\_\_

Mail 1 white copy along with a fee of \$5.00 for each constructed well to: Kansas Department of Health and Environment, Bureau of Water, GWTS Section, 1000 SW Jackson St., Suite 420, Topeka, Kansas 66612-1367. Mail one to Water Well Owner and retain one for your records. Telephone 785-296-5524.

# TRITERRA

## LAND SERVICES

P.O. Box 546  
 Clearwater, Kansas 67026  
 Office (620) 584-2313 Cell (316) 648-3617  
 Fax (620) 584-4371  
 E-mail: triterrals@yahoo.com

**SURVEYING OF MONITORING WELLS**  
**L & S MOTORS**  
**IOLA, KANSAS**

The above site is located in Section 36, Township 24 South, Range 18 East of the Sixth Principal Meridian, Allen County, Kansas. The Southeast corner of Section 36 was assigned coordinates of 00.00 North and 00.00 West.

The control point from a nearby site, Convenient Mart, was used for vertical control. A control point was established on site as a chiseled 'X' at the southwest corner of the parking lot.

The Latitude and Longitude were recorded from a GPS unit. The site is located on the 7.5' quad map titled "Iola".

ID	NORTH	WEST	LATITUDE	LONGITUDE	ELEVATION
SE CORNER 36-24S-18E	00.00	00.00			
CP	5213.20	4797.50	37.92194	95.38916	963.37
MW-1 NE NW NW NW	5238.64	4656.91	37.92200	95.38869	RIM 963.09 TOC 962.80
MW-2 NE NW NW NW	5156.44	4688.08	37.92176	95.38876	RIM 961.71 TOC 961.32
MW-3 NE NW NW NW	5191.90	4644.83	37.92186	95.38863	RIM 962.05 TOC 961.77
MW-4 NE NW NW NW	5232.73	4808.50	37.92198	95.38921	RIM 963.34 TOC 963.03
MW-5 NE NW NW NW	5217.25	4707.99	37.92194	95.38885	RIM 963.40 TOC 963.12
MW-6 NW NE NW NW	5237.78	4499.27	37.92200	95.38811	RIM 962.19 TOC 961.78
MW-7 NW NE NW NW	5207.53	4583.21	37.92192	95.38840	RIM 962.28 TOC 962.02
MW-8(Sec 25) SE SW SW SW	5324.95	4630.40	37.92225	95.38858	RIM 963.63 TOC 963.20
MW-9 NW NE NW NW	5148.31	4512.94	37.92176	95.38817	RIM 961.06 TOC 960.78

