

1 LOCATION OF WATER WELL: County: Allen Fraction NW 1/4 NW 1/4 NW 1/4 NW 1/4 Section Number 35 Township Number T 24 S Range Number 18 [X] E [ ] W

Street/Rural Address of Well Location; if unknown, distance & direction from nearest town or intersection: If at owner's address, check here [ ] -390' west of 201 S. State St, Iola, KS

Global Positioning Systems (GPS) information: Latitude: 37.92088 (in decimal degrees) Longitude: 95.41030 (in decimal degrees) Elevation: NA Horizontal Datum [X] WGS84, [ ] NAD83, [ ] NAD27 Collection Method:

2 WATER WELL OWNER: Greenfield Environmental Multistate Trust LLC RR#, St. Address, Box #: PO Box 568 City, State ZIP Code: Beloit, KS 67420

GPS unit (Make/model): [ ] Digital Map/Photo, [ ] Topographic Map, [ ] Land Survey Est. Accuracy: [ ] <3 m, [ ] 3-5 m, [ ] 5-15 m, [ ] >15 m

3 MARK WELL'S LOCATION WITH AN "X" IN SECTION BOX: [Diagram showing a 3x3 grid with 'X' in the NW section and cardinal directions N, S, E, W]

4 DEPTH OF WELL 19.13 ft. WELL'S STATIC WATER LEVEL NA ft. WELL WAS USED AS: [ ] Domestic, [ ] Irrigation, [ ] Feedlot, [ ] Industrial, [ ] Public Water Supply, [ ] Oil Field Water Supply, [ ] Domestic (Lawn & Garden), [ ] Air Conditioning, [ ] Dewatering, [X] Monitoring, [ ] Injection Well, [ ] Other. Was a chemical/bacteriological sample submitted to Department? Yes [ ] No [X]

5 TYPE OF BLANK CASING USED: [ ] Steel, [X] PVC, [ ] RMP (SR), [ ] ABS, [ ] Wrought, [ ] Asbestos-Cement, [ ] Fiberglass, [ ] Concrete Tile, [ ] Other (Specific below). Blank casing diameter 2 in. Was casing pulled? Yes [ ] No [X] If yes, how much 3'

6 GROUT PLUG MATERIAL: [ ] Neat cement, [ ] Cement grout, [X] Bentonite, [X] Other Soil: 0-3'. Grout Plug Intervals: From 3 ft to 19.13 ft, From [ ] ft to [ ] ft, From [ ] ft to [ ] ft. What is the nearest source of possible contamination: [ ] Septic tank, [ ] Sewer lines, [ ] Watertight sewer lines, [ ] Lateral lines, [ ] Cess pool, [ ] Seepage pit, [ ] Pit privy, [ ] Sewage lagoon, [ ] Feed yard, [ ] Livestock pens, [ ] Fuel storage, [ ] Fertilizer storage, [ ] Insecticide storage, [ ] Abandoned water well, [ ] Oil well/Gas well, [ ] Other (specify below). Direction from well? [ ] How many feet? [ ]

Table with columns: FROM, TO, PLUGGING MATERIALS. Rows: 0 to 3 (Soil), 3 to 19.13 (Bentonite). Includes KDHE ID: Kerr McGee #121-7330; U3-001-00076

7 CONTRACTOR'S OR LANDOWNER'S CERTIFICATION: This water well was plugged under my jurisdiction and was completed on (mo/day/year) 4/24/2023 and this record is true to the best of my knowledge and belief. Kansas Water Contractor's License No. 757. This Water Well Record was completed on (mo/day/year) 5/1/2023 under the business name of Larsen & Associates, Inc. By (signature) [Signature]

Send one white copy to Kansas Department of Health & Environment, Geology Section, 1000 SW Jackson Street, Ste. 420, Topeka, KS 66612-1367. Send one copy to WATER WELL OWNER and retain one for your records Visit us at http://www.kdheks.gov/waterwell/index.html Telephone 785-296-5524.

NOTE: Figures exhibited within this report are only to be used within the context of this report. Placement of property lines, wells, structures, and roads is based on the available information from county appraiser maps, surveys, site visits, and/or previous vendor reports and should be considered approximate.

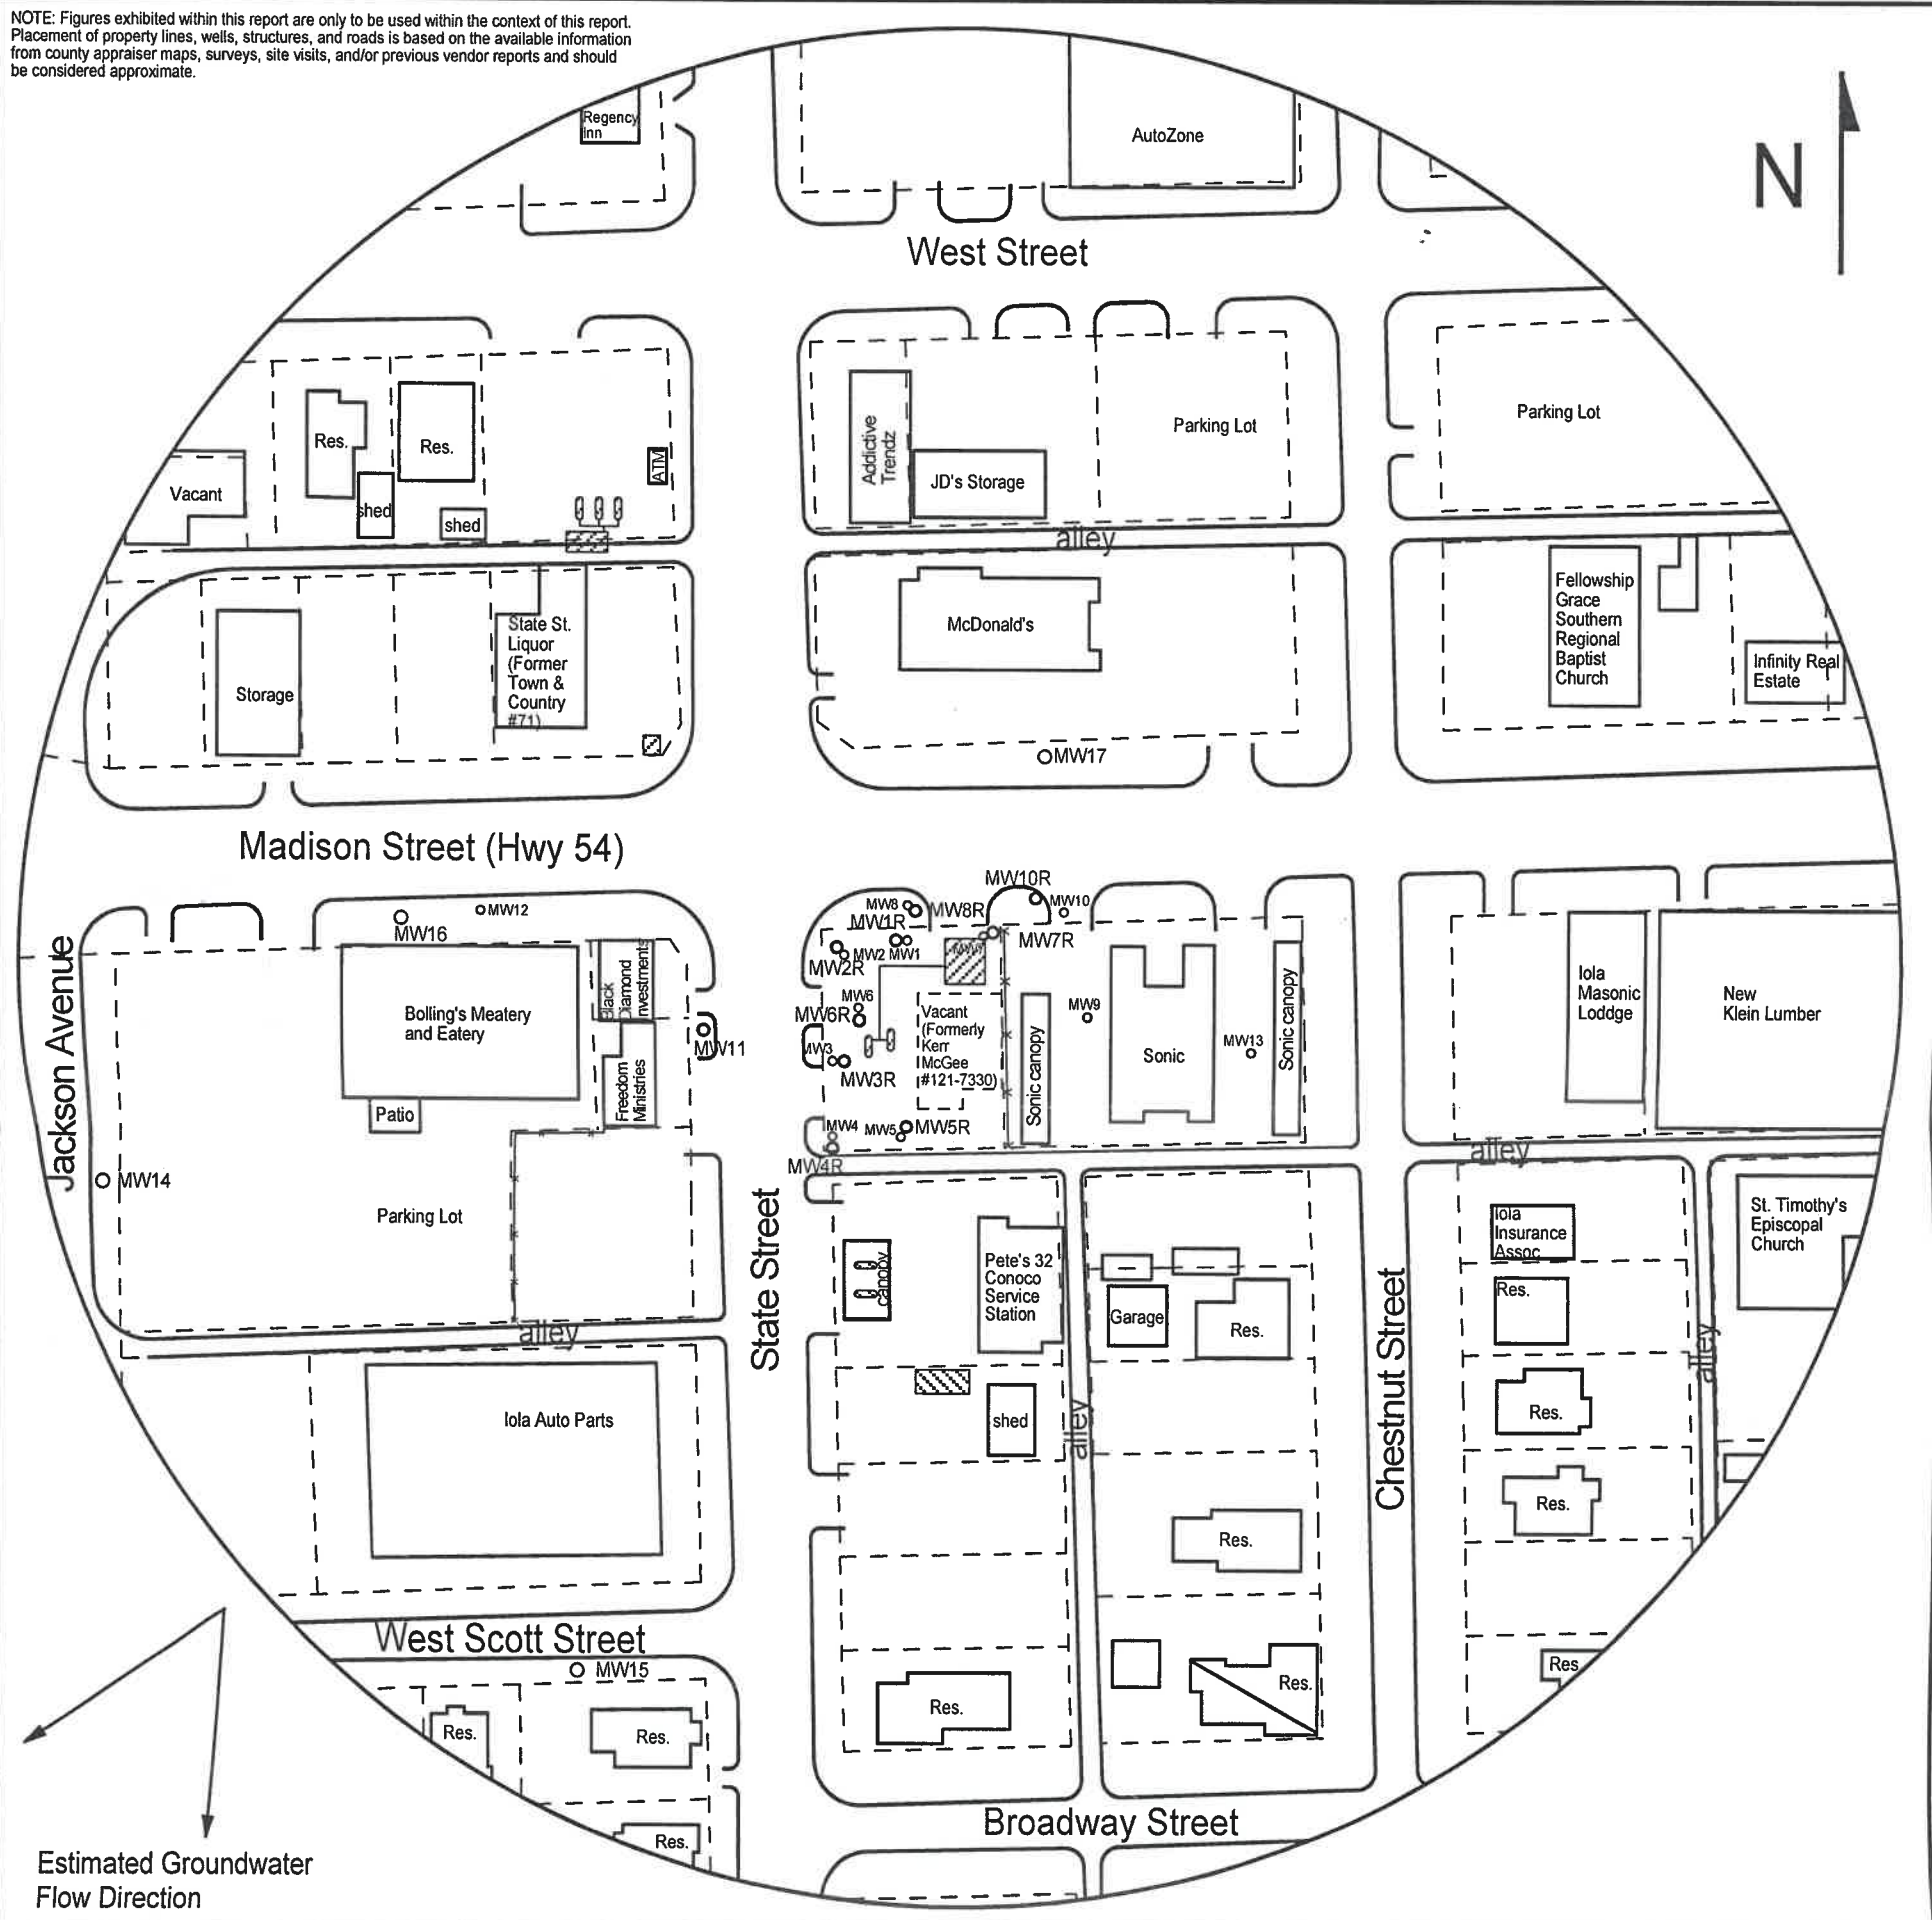


FIGURE 1 - 500 FT RADIUS AREA BASE MAP

**LEGEND**

- Approximate Location of Former UST Basin, Product Lines & Pump Islands
- Approximate Location of Active UST Basin & Pump Islands
- Building with Basement
- Approximate Location of Property Line
- Existing Monitoring Well
- Plugged Monitoring Well
- Monitoring Well Plugged nearby site Town & Country #71 (#U3-001-00583)

**PROJECT:**

Kerr McGee #121-7330  
 201 S. State Street  
 Iowa, KS  
 KDHE ID: U3-001-00076  
 Date: 4/24/23



1311 E 25th St., Suite B    785-841-8707 office  
 Lawrence, KS 66046    785-865-4282 fax