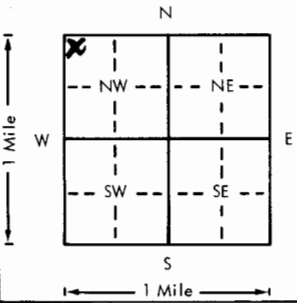


USE TYPEWRITER OR BALL
POINT PEN-PRESS FIRMLY,
PRINT CLEARLY.

WATER WELL RECORD
KSA 82a-1201-1215

Kansas Department of Health and
Environment-Division of Environment
(Water well Contractors)
Topeka, Kansas 66620

1. Location of well:		County HARVEY	Fraction NW 1/4 NW 1/4 NW 1/4	Section number 25	Township number T 24	Range number S R 2-E	E/W
2. Distance and direction from nearest town or city: 1 W 15		FROM WHITEWATER		Owner of well: Ivan Sexton			
Street address of well location if in city:		R.R. or street: Rt #1		City, state, zip code: Moundridge, Kansas 67107			
4. Locate with "X" in section below:		Sketch map:		6. Bore hole dia. 8 in. Completion date 5-1-79 Well depth 60 ft.			
				7. <input checked="" type="checkbox"/> Cable tool <input checked="" type="checkbox"/> Rotary <input type="checkbox"/> Driven <input type="checkbox"/> Dug <input type="checkbox"/> Hollow rod <input type="checkbox"/> Jetted <input type="checkbox"/> Bored <input type="checkbox"/> Reverse rotary			
5. Type and color of material		From		To		8. Use: <input checked="" type="checkbox"/> Domestic <input type="checkbox"/> Public supply <input type="checkbox"/> Industry <input type="checkbox"/> Irrigation <input type="checkbox"/> Air conditioning <input type="checkbox"/> Stock <input type="checkbox"/> Lawn <input type="checkbox"/> Oil field water <input type="checkbox"/> Other	
BLACK DIRT		0		10		9. Casing: Material Plastic Height: Above or below Threaded <input type="checkbox"/> Welded <input checked="" type="checkbox"/> Surface 24 in. RMP <input checked="" type="checkbox"/> PVC <input type="checkbox"/> Weight <input type="checkbox"/> lbs./ft. Dia. 5 in. to 40 ft. depth Wall Thickness: inches or Dia. <input type="checkbox"/> in. to <input type="checkbox"/> ft. depth gage No. 200	
CLAY - BROWN		10		25		10. Screen: Manufacturer's name Sunflower Plastic Pipe Type 200 Dia. 5 1/8 Slot/gauze 5/16 Length 40 Set between 40 ft. and 60 ft. Gravel pack? Yes Size range of material 1/4 - 1/2	
CLAY - GRAY		25		40		11. Static water level: 8 mo./day/yr. 8 ft. below land surface Date 5-1-79	
COURSE SAND		40		45		12. Pumping level below land surfaces: ____ ft. after ____ hrs. pumping ____ g.p.m. ____ ft. after ____ hrs. pumping ____ g.p.m. Estimated maximum yield 9 g.p.m.	
CLAY		45		55		13. Water sample submitted: ____ mo./day/yr. <input type="checkbox"/> Yes <input checked="" type="checkbox"/> No Date ____	
SHALE		55		60		14. Well head completion: <input checked="" type="checkbox"/> Pitless adapter 36 Inches above grade	
						15. Well grouted? Yes With: <input type="checkbox"/> Neat cement <input type="checkbox"/> Bentonite <input checked="" type="checkbox"/> Concrete Depth: From 3 ft. to 13 ft.	
						16. Nearest source of possible contamination: ft. 200 Direction SE Type LAGON Well disinfected upon completion? <input checked="" type="checkbox"/> Yes <input type="checkbox"/> No	
						17. Pump: <input checked="" type="checkbox"/> Not installed Manufacturer's name ____ Model number ____ HP ____ Volts ____ Length of drop pipe ____ ft. capacity ____ g.p.m. Type: <input type="checkbox"/> Submersible <input type="checkbox"/> Turbine <input type="checkbox"/> Jet <input type="checkbox"/> Reciprocating <input type="checkbox"/> Centrifugal <input type="checkbox"/> Other	
18. Elevation:		19. Remarks:		20. Water well contractor's certification: This well was drilled under my jurisdiction and this report is true to the best of my knowledge and belief. Martin Supply 362 Business name License No. 500 West 22nd Address 1/4 NW 1/4 Signed Bruce J. Howard Date 5-1-79 Authorized Representative			

Forward the white, blue and pink copies to the Department of Health and Environment

Form WWC-5