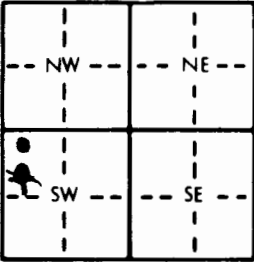
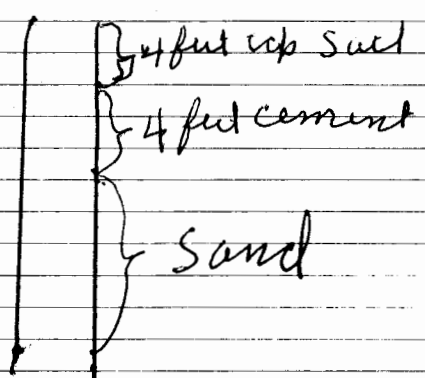


1 LOCATION OF WATER WELL: County: <u>Harvey</u> Distance and direction from nearest town or city street address of well if located within city? <u>3 mi South + 8 1/2 East of Newton</u>		Fraction <u>NW 1/4 NW 1/4 SW 1/4</u>		Section Number <u>1</u>		Township Number <u>T 24 S</u>		Range Number <u>R 2 E</u>	
2 WATER WELL OWNER: RR#, St. Address, Box # : City, State, ZIP Code : <u>Harold Busenitz</u> <u>RI Whitewater Kansas</u>					Board of Agriculture, Division of Water Resources Application Number:				
3 LOCATE WELL'S LOCATION WITH AN "X" IN SECTION BOX: 			4 DEPTH OF COMPLETED WELL: <u>40</u> ft. ELEVATION: Depth(s) Groundwater Encountered 1. <u>15</u> ft. 2. <u>20</u> ft. 3. <u>40</u> ft. WELL'S STATIC WATER LEVEL <u>15</u> ft. below land surface measured on mo/day/yr <u>Jan 16 1995</u> Pump test data: Well water was <u>20</u> ft. after <u>1</u> hours pumping <u>13</u> gpm Est. Yield <u>13</u> gpm: Well water was <u>20</u> ft. after <u>1</u> hours pumping <u>13</u> gpm Bore Hole Diameter <u>8</u> in. to <u>40</u> ft., and <u>40</u> in. to <u>40</u> ft. WELL WATER TO BE USED AS: <input checked="" type="checkbox"/> 1 Domestic <input type="checkbox"/> 3 Feedlot <input type="checkbox"/> 6 Oil field water supply <input type="checkbox"/> 9 Dewatering <input type="checkbox"/> 12 Other (Specify below) <input type="checkbox"/> 2 Irrigation <input type="checkbox"/> 4 Industrial <input type="checkbox"/> 7 Lawn and garden only <input type="checkbox"/> 10 Monitoring well Was a chemical/bacteriological sample submitted to Department? Yes <u> </u> No <u> </u> ; If yes, mo/day/yr sample was submitted <u> </u> Water Well Disinfected? Yes <u> </u> No <u> </u>						
5 TYPE OF BLANK CASING USED: 1 Steel 3 RMP (SR) 5 Wrought iron 8 Concrete tile 2 PVC 4 ABS 6 Asbestos-Cement 9 Other (specify below) 7 Fiberglass Blank casing diameter <u> </u> in. to <u> </u> ft., Dia <u> </u> in. to <u> </u> ft., Dia <u> </u> in. to <u> </u> ft. Casing height above land surface <u> </u> in., weight <u> </u> lbs./ft. Wall thickness or gauge No. <u> </u> TYPE OF SCREEN OR PERFORATION MATERIAL: 1 Steel 3 Stainless steel 5 Fiberglass 7 PVC 10 Asbestos-cement 2 Brass 4 Galvanized steel 6 Concrete tile 8 RMP (SR) 11 Other (specify) <u> </u> 9 ABS 12 None used (open hole) SCREEN OR PERFORATION OPENINGS ARE: 1 Continuous slot 3 Mill slot 5 Gauzed wrapped 8 Saw cut 11 None (open hole) 2 Louvered shutter 4 Key punched 6 Wire wrapped 9 Drilled holes 7 Torch cut 10 Other (specify) <u> </u> SCREEN-PERFORATED INTERVALS: From <u> </u> ft. to <u> </u> ft., From <u> </u> ft. to <u> </u> ft., From <u> </u> ft. to <u> </u> ft. GRAVEL PACK INTERVALS: From <u> </u> ft. to <u> </u> ft., From <u> </u> ft. to <u> </u> ft., From <u> </u> ft. to <u> </u> ft.					CASING JOINTS: Glued <u> </u> Clamped <u> </u> Welded <u> </u> Threaded <u> </u>				
6 GROUT MATERIAL: <input checked="" type="checkbox"/> 1 Neat cement <input type="checkbox"/> 2 Cement grout <input type="checkbox"/> 3 Bentonite <input type="checkbox"/> 4 Other <u> </u> Grout Intervals: From <u>0</u> ft. to <u>4</u> ft., From <u> </u> ft. to <u> </u> ft., From <u> </u> ft. to <u> </u> ft. What is the nearest source of possible contamination: 1 Septic tank 4 Lateral lines 7 Pit privy 10 Livestock pens 14 Abandoned water well 2 Sewer lines 5 Cess pool 8 Sewage lagoon 11 Fuel storage 15 <u>Oil well</u> Gas well 3 Watertight sewer lines 6 Seepage pit 9 Feedyard 12 Fertilizer storage 16 Other (specify below) <u> </u> 13 Insecticide storage Direction from well? <u>West</u> How many feet? <u>4 mi</u>									
FROM TO LITHOLOGIC LOG			FROM TO PLUGGING INTERVALS						
0	4	top soil							
4	10	Brown clay							
10	15	light Brown clay							
15	25	Blue clay							
25	30	Cracking Blue Shale							
30	40	Blue Shale							
well no good water									
7 CONTRACTOR'S OR LANDOWNER'S CERTIFICATION: This water well was (1) constructed, (2) reconstructed, or (3) plugged under my jurisdiction and was completed on (mo/day/year) <u>Jan 17 1995</u> and this record is true to the best of my knowledge and belief. Kansas Water Well Contractor's License No. <u>221</u> This Water Well Record was completed on (mo/day/yr) <u>Feb 1 1995</u> under the business name of <u>Frank Buckle</u> by (signature) <u>Frank Buckle</u>									