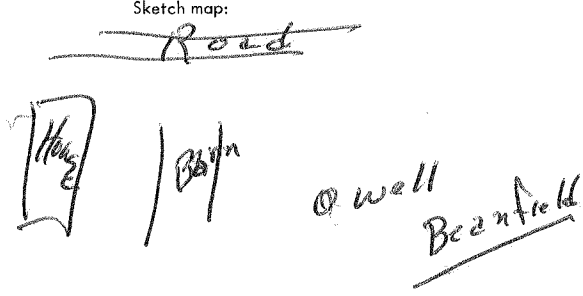
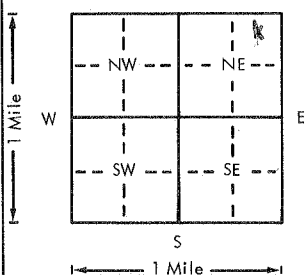


USE TYPEWRITER OR BALL
POINT PEN-PRESS FIRMLY,
PRINT CLEARLY.

WATER WELL RECORD
KSA 82a-1201-1215

Kansas Department of Health and
Environment-Division of Environment
(Water well Contractors)
Topeka, Kansas 66620

| | | | | | |
|---|---|--------------------------------------|---|--|------------------------------|
| 1. Location of well: | County <u>Allen</u> | Fraction <u>NE 1/4 NE 1/4 NE 1/4</u> | Section number <u>10</u> | Township number <u>T 24 S</u> | Range number <u>R 20 E/W</u> |
| 2. Distance and direction from nearest town or city: Street address of well location if in city: | <u>4 1/2 Miles N Moran, Kans 1 1/4 M. W</u> <u>Moran Kans</u> | | 3. Owner of well: <u>Don Garrison</u> R.R. or street: <u>RR</u> City, state, zip code: <u>Kincaid, Kans</u> | | |
| 4. Locate with "X" in section below: | Sketch map:  | | 6. Bore hole dia. <u>8 3/4</u> in. Completion date <u>7/18/78</u> Well depth <u>210</u> ft. | | |
|  | | | 7. <input checked="" type="checkbox"/> Cable tool <input type="checkbox"/> Rotary <input type="checkbox"/> Driven <input type="checkbox"/> Dug <input type="checkbox"/> Hollow rod <input type="checkbox"/> Jetted <input type="checkbox"/> Bored <input type="checkbox"/> Reverse rotary | | |
| | | | 8. Use: <input type="checkbox"/> Domestic <input type="checkbox"/> Public supply <input type="checkbox"/> Industry <input type="checkbox"/> Irrigation <input type="checkbox"/> Air conditioning <input checked="" type="checkbox"/> Stock <input type="checkbox"/> Lawn <input type="checkbox"/> Oil field water <input type="checkbox"/> Other | | |
| 5. Type and color of material | | From | To | 9. Casing: Material <input type="checkbox"/> Height: Above or below Threaded <input type="checkbox"/> Welded <input type="checkbox"/> Surface <u>12</u> in. RMP <input type="checkbox"/> PVC <input checked="" type="checkbox"/> Weight <u>160</u> lbs./ft. Dia. <u>5</u> in. to <u>160</u> ft. depth Wall Thickness: inches or Dia. <u>5</u> in. to <u>160</u> ft. depth gage No. <u>255</u> | |
| | | | | 10. Screen: Manufacturer's name <u>Jetstream</u> Type <u>Jetstream</u> Dia. <u>160</u> Slot/gauze <u>160</u> Length <u>210</u> ft. Set between <u>160</u> ft. and <u>210</u> ft. Gravel pack? <input checked="" type="checkbox"/> Size range of material <u>1/4" to 1/2"</u> | |
| | | | | 11. Static water level: <u>70</u> ft. below land surface Date <u>7/18/78</u> mo./day/yr. | |
| | | | | 12. Pumping level below land surface: ft. after <u>10</u> hrs. pumping <u>10</u> g.p.m. ft. after <u>10</u> hrs. pumping <u>10</u> g.p.m. Estimated maximum yield <u>10</u> g.p.m. | |
| | | | | 13. Water sample submitted: <u>Yes</u> <input checked="" type="checkbox"/> No <input type="checkbox"/> Date <u>7/18/78</u> mo./day/yr. | |
| | | | | 14. Well head completion: <u>None</u> <input type="checkbox"/> Pitless adapter <input type="checkbox"/> Inches above grade | |
| | | | | 15. Well grouted? <input checked="" type="checkbox"/> With: <input checked="" type="checkbox"/> Neat cement <input type="checkbox"/> Bentonite <input type="checkbox"/> Concrete Depth: From <u>0</u> ft. to <u>10</u> ft. | |
| | | | | 16. Nearest source of possible contamination: <u>Septic</u> ft. <u>200</u> Direction <u>West</u> Type <u>Septic</u> Well disinfected upon completion? <input checked="" type="checkbox"/> Yes <input type="checkbox"/> No | |
| | | | | 17. Pump: <input checked="" type="checkbox"/> Not installed Manufacturer's name <u>Eureka Well Service</u> Model number <u>296</u> HP <u>1/4</u> Volts <u>115</u> Length of drop pipe <u>10</u> ft. capacity <u>10</u> g.p.m. Type: <input type="checkbox"/> Submersible <input type="checkbox"/> Turbine <input type="checkbox"/> Jet <input type="checkbox"/> Reciprocating <input type="checkbox"/> Centrifugal <input type="checkbox"/> Other | |
| | | (Use a second sheet if needed) | | | |
| 18. Elevation: | 19. Remarks: | | 20. Water well contractor's certification: This well was drilled under my jurisdiction and this report is true to the best of my knowledge and belief. <u>Eureka Well Service</u> Business name <u>225 Walnut Eureka, KS</u> License No. <u>10-22</u> Address <u>True Ashlock</u> Signed <u>True Ashlock</u> Date <u>7/18/78</u> Authorized representative | | |
| Topography: <input type="checkbox"/> Hill <input type="checkbox"/> Slope <input checked="" type="checkbox"/> Upland <input type="checkbox"/> Valley | | | | | |

Forward the white, blue and pink copies to the Department of Health and Environment

Form WWC-5