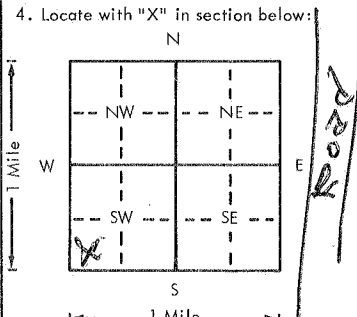


USE TYPEWRITER OR BALL
POINT PEN-PRESS FIRMLY,
PRINT CLEARLY.

WATER WELL RECORD
KSA 82a-1201-1215

Kansas Department of Health and
Environment-Division of Environment
(Water well Contractors)
Topeka, Kansas 66620

1. Location of well:	County: <u>Allen</u>	Fraction: <u>SW 1/4 SW 1/4 SW 1/4</u>	Section number: <u>10</u>	Township number: <u>T 24 S</u>	Range number: <u>R 20 E/W</u>
2. Distance and direction from nearest town or city: <u>2 miles West-3 North Moran, Ks.</u>			3. Owner of well: <u>Jesse E. Parsons</u> R.R. or street: <u>KRI</u> City, state, zip code: <u>Moran, Kansas 66755</u>		
4. Locate with "X" in section below:			Sketch map: <u>Timber Lake</u> <u>Approx 200 yds. from K well</u> <u>Grassland</u>		
			6. Bore hole dia. <u>8 1/4</u> in. Completion date <u>5/1/79</u> Well depth <u>160</u> ft. 7. <input checked="" type="checkbox"/> Cable tool <input type="checkbox"/> Rotary <input type="checkbox"/> Driven <input type="checkbox"/> Dug <input type="checkbox"/> Hollow rod <input type="checkbox"/> Jetted <input type="checkbox"/> Bored <input type="checkbox"/> Reverse rotary 8. Use: <input checked="" type="checkbox"/> Domestic <input type="checkbox"/> Public supply <input type="checkbox"/> Industry <input type="checkbox"/> Irrigation <input type="checkbox"/> Air conditioning <input type="checkbox"/> Stock <input type="checkbox"/> Lawn <input type="checkbox"/> Oil field water <input type="checkbox"/> Other 9. Casing: Material <u>UPPER</u> Height: Above or below Threaded <input type="checkbox"/> Welded <input type="checkbox"/> Surface <u>12</u> ft. RMP <input type="checkbox"/> PVC <input checked="" type="checkbox"/> Weight <u>12</u> lbs./ft. Dia. <u>6</u> in. to <u>160</u> ft. depth Wall Thickness: inches or Dia. <u>6</u> in. to <u>160</u> ft. depth gage No. <u>245</u>		
5. Type and color of material			From	To	
Soil			0	1	
Clay - yellow			1	5	
Hard - Lime			5	17	
"Water Approx 2 gpm" Gray sand			17	20	
Gray Sandy Shale			20	30	
Blue Shale			30	60	
Lime			60	61	
Blue Shale			61	64	
Lime			64	65	
Blue Shale			65	66	
"Very" Hard lime			66	95	
Small increase in "Gray Sandy Shale"			95	122	
Lime			122	124	
Gray Sandy Shale			124	160	
(Use a second sheet if needed)					
18. Elevation:		19. Remarks:			
Topography: <input type="checkbox"/> Hill <input checked="" type="checkbox"/> Slope <input type="checkbox"/> Upland <input type="checkbox"/> Valley					
20. Water well contractor's certification: This well was drilled under my jurisdiction and this report is true to the best of my knowledge and belief. <u>Nichols Well Drilling</u> 377 Business name <u>RR# Box 45 Liberal MO</u> License No. Address <u>6176 E</u> Signed <u>Robert Nichols</u> Date <u>5/1/79</u> Authorized representative					

Forward the white, blue and pink copies to the Department of Health and Environment

Form WWC-5