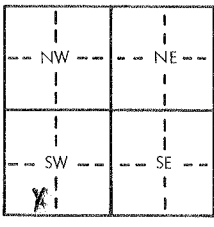
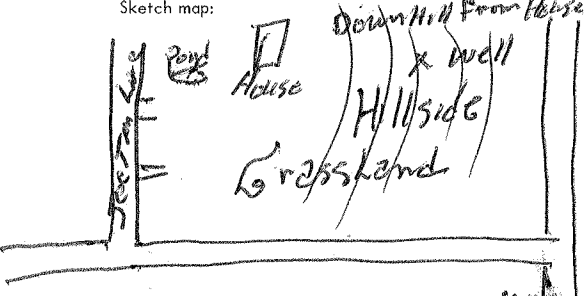


USE TYPEWRITER OR BALL
POINT PEN-PRESS FIRMLY,
PRINT CLEARLY.

WATER WELL RECORD
KSA 82a-1201-1215

Kansas Department of Health and
Environment-Division of Environment
(Water well Contractors)
Topeka, Kansas 66620

1. Location of well: County <u>Allen</u>		Fraction <u>W 1/2 SE 1/4 SW 1/4</u>	Section number <u>14</u>	Township number <u>T 24 S</u>	Range number <u>R 20 E/W</u>
2. Distance and direction from nearest town or city: <u>1 mile W 2 1/2 mile N of Moran</u>			3. Owner of well: <u>George J Meiwes</u> Phone <u>316-237-4581</u> R.R. or street: <u>RR #</u> City, state, zip code: <u>Moran, Kansas 66755</u>		
4. Locate with "X" in section below:		Sketch map:		6. Bore hole dia. <u>8 3/4</u> in. Completion date <u>5/10/74</u> Well depth <u>121</u> ft.	
				7. ☒ Cable tool ☐ Rotary ☐ Driven ☐ Dug ☐ Hollow rod ☐ Jetted ☐ Bored ☐ Reverse rotary	
5. Type and color of material		From	To	8. Use: ☒ Domestic ☐ Public supply ☐ Industry ☐ Irrigation ☐ Air conditioning ☐ Stock ☐ Lawn ☐ Oil field water ☐ Other	
				9. Casing: Material ☐ Height: Above or below Threaded ☐ Welded ☐ Surface ☐ in. RMP ☐ PVC ☒ Weight ☐ lbs./ft. Dia. ☐ in. to ☐ ft. depth Wall Thickness: inches or Dia. ☐ in. to ☐ ft. depth gage No. ☐	
				10. Screen: Manufacturer's name ☐ Type ☐ Dia. ☐ Slot/gauze ☐ Length ☐ Set between ☒ ft. and ☐ ft. ☐ ft. and ☐ ft. Gravel pack? ☐ Size range of material ☐	
				11. Static water level: ☐ mo./day/yr. ☐ ft. below land surface Date ☐	
				12. Pumping level below land surfaces: ☐ ft. after ☐ hrs. pumping ☐ g.p.m. ☐ ft. after ☒ hrs. pumping ☐ g.p.m. Estimated maximum yield ☐ g.p.m.	
				13. Water sample submitted: ☐ mo./day/yr. ☐ Yes ☒ No Date ☐	
				14. Well head completion: ☐ ☐ Pitless adapter ☒ Inches above grade	
				15. Well grouted? ☒ Yes With: ☒ Neat cement ☐ Bentonite ☐ Concrete Depth: From ☐ ft. to ☐ ft.	
				16. Nearest source of possible contamination: ☐ a. ☒ direction <u>SW</u> Type <u>Pond</u> Well disinfected upon completion? ☐ Yes ☐ No	
				17. Pump: ☐ Not installed Manufacturer's name ☐ Model number ☐ HP ☐ Volts ☐ Length of drop pipe ☐ ft. capacity ☐ g.p.m. Type: ☐ Submersible ☐ Turbine ☐ Jet ☐ Reciprocating ☐ Centrifugal ☐ Other	
18. Elevation:		19. Remarks:		20. Water well contractor's certification:	
Topography: ☒ Hill ☐ Slope ☐ Upland ☐ Valley		<u>Hole Dry -</u> <u>Plugged with Cuttings</u> <u>4 ton Crushed Rock 1" to 1 1/2"</u> <u>Cement within plow depth</u>		This well was drilled under my jurisdiction and this report is true to the best of my knowledge and belief. <u>Nichols WTR Well Co.</u> 377 Business name License No. Address <u>RR # 1, Liberal, Mo 64112</u> Signed <u>Don Nichols</u> Date <u>6/20/74</u> Authorized representative	

Forward the white, blue and pink copies to the Department of Health and Environment

Form WWC-5