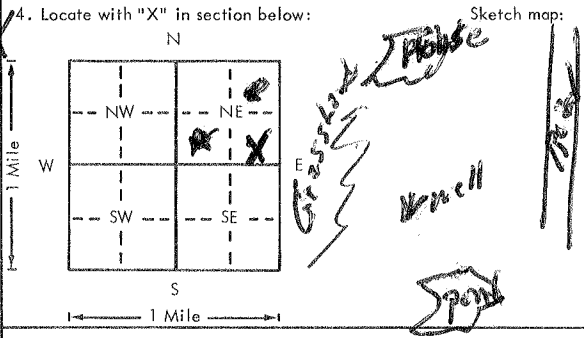


USE TYPEWRITER OR BALL
POINT PEN-PRESS FIRMLY,
PRINT CLEARLY.

WATER WELL RECORD
KSA 82a-1201-1215

Kansas Department of Health and
Environment-Division of Environment
(Water well Contractors)
Topeka, Kansas 66620

1. Location of well:	County <u>Allen</u>	Traction <u>SE 1/4 NE 1/4</u>	Section number <u>15</u>	Township number <u>T 24</u>	Range number <u>S R 20</u>	<u>EW</u>
2. Distance and direction from nearest town or city: <u>1 West 3 N Moran, Kans</u> Street address of well location if in city:			3. Owner of well: <u>Gene Cochran</u> R.R. or street: <u>RR</u> City, state, zip code: <u>Moran, Kansas</u>			
4. Locate with "X" in section below: 			6. Bore hole dia. <u>4 1/4</u> in. Completion date <u>10/28/78</u> Well depth <u>270</u> ft.			
5. Type and color of material			7. ☒ Cable tool ☐ Rotary ☐ Driven ☐ Dug ☐ Hollow rod ☐ Jetted ☐ Bored ☐ Reverse rotary			
			8. Use: ☐ Domestic ☐ Public supply ☐ Industry ☐ Irrigation ☐ Air conditioning ☒ Stock ☐ Lawn ☐ Oil field water ☐ Other			
			9. Casing: Material <u>galvanneal</u> Height: Above or below Threaded ☐ Welded ☐ Surface <u>12</u> in. RMP ☐ PVC ☒ Weight <u>12</u> lbs./ft. Dia. <u>5 1/2</u> in. to <u>190</u> ft. depth Wall Thickness: inches or Dia. <u>5 1/2</u> in. to <u>190</u> ft. depth gage No. <u>275</u>			
			10. Screen: Manufacturer's name <u>Jet stream</u> Type <u>100</u> Dia. <u>100</u> Slot/gauze <u>0.30</u> Length <u>190</u> ft. Set between <u>190</u> ft. and <u>270</u> ft. Gravel pack? ☒ Size range of material <u>1/4 to 3/4</u>			
			11. Static water level: <u>40</u> ft. below land surface Date <u>10/28/78</u> mo./day/yr.			
			12. Pumping level below land surfaces: ____ ft. after ____ hrs. pumping ____ g.p.m. ____ ft. after ____ hrs. pumping ____ g.p.m. Estimated maximum yield ____ g.p.m.			
			13. Water sample submitted: ____ mo./day/yr. Yes ☒ No ☐ Date ____			
			14. Well head completion: <u>12"</u> inches above grade ____ Pitless adapter			
			15. Well grouted? ☒ Yes With: ☒ Neat cement ☐ Bentonite ☐ Concrete Depth: From <u>0</u> ft. to <u>10</u> ft.			
			16. Nearest source of possible contamination: <u>160 yds</u> Direction <u>N</u> Type <u>Septic</u> Well disinfected upon completion? ☒ Yes ☐ No			
			17. Pump: ☒ Not installed Manufacturer's name ____ Model number ____ HP ____ Volts ____ Length of drop pipe ____ ft. capacity ____ g.p.m. Type: ☐ Submersible ☐ Turbine ☐ Jet ☐ Reciprocating ☐ Centrifugal ☐ Other			
			20. Water well contractor's certification: This well was drilled under my jurisdiction and this report is true to the best of my knowledge and belief. <u>Eurek's Well Service</u> <u>296</u> Business name License No. Address <u>Eureka, Kans 225 S Walnut</u> Signed <u>Gene Cochran</u> <u>10-28-78</u> Authorized representative			
18. Elevation:		19. Remarks:				
Topography: ☒ Hill ☐ Slope ☐ Upland ☐ Valley						

Forward the white, blue and pink copies to the Department of Health and Environment

Form WWC-5