

**WATER WELL PLUGGING RECORD Form WWC-5P**

KSA 82a-1212136589

# 1


|  |  |                             |                                  |  |
|--|--|-----------------------------|----------------------------------|--|
| <b>1 LOCATION OF WATER WELL:</b><br>County: <u>Allen</u> | Fraction<br><u>SE 1/4 NE 1/4 NE 1/4 NE 1/4</u> | Section Number<br><u>30</u> | Township Number<br><u>24 T S</u> | Range Number<br><u>20</u> <input checked="" type="checkbox"/> E <input type="checkbox"/> W |
|--|--|-----------------------------|----------------------------------|--|

Street/Rural Address of Well Location; if unknown, distance & direction from nearest town or intersection: If at owner's address, check here  3200th Street Moran, Kansas 66755

**Global Positioning Systems (GPS) information:**  
 Latitude: 37.9348322 (in decimal degrees)  
 Longitude: 95.24418322 (in decimal degrees)  
 Elevation: 1050  
 Datum:  WGS84,  NAD83,  NAD27  
 Collection Method:

**2 WATER WELL OWNER:** Magellan Pipeline  
 RR#, St. Address, Box #: One Williams Plaza  
 City, State ZIP Code: Tulsa OK 74172

GPS unit (Make/Model: \_\_\_\_\_)  
 Digital Map/Photo,  Topographic Map,  Land Survey  
 Est. Accuracy:  < 3 m,  3-5 m,  5-15 m,  > 15 m

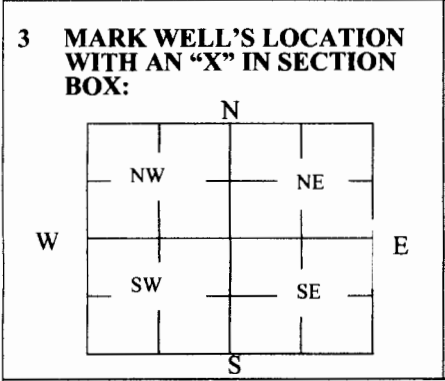

**4 DEPTH OF WELL** 20 ft.  
 WELL'S STATIC WATER LEVEL 4 ft.  
 WELL WAS USED AS:

|                                     |   |  |
|-------------------------------------|---|--|
| <input type="checkbox"/> Domestic   | <input type="checkbox"/> Public Water Supply      | <input type="checkbox"/> Dewatering            |
| <input type="checkbox"/> Irrigation | <input type="checkbox"/> Oil Field Water Supply   | <input checked="" type="checkbox"/> Monitoring |
| <input type="checkbox"/> Feedlot    | <input type="checkbox"/> Domestic (Lawn & Garden) | <input type="checkbox"/> Injection Well        |
| <input type="checkbox"/> Industrial | <input type="checkbox"/> Air Conditioning         | <input type="checkbox"/> Other _____           |

Was a chemical/bacteriological sample submitted to Department? Yes  No

**5 TYPE OF BLANK CASING USED:**

|   |                                   |  |  |  |
|---|-----------------------------------|--|--|--|
| <input type="checkbox"/> Steel          | <input type="checkbox"/> RMP (SR) | <input type="checkbox"/> Wrought         | <input type="checkbox"/> Fiberglass    | <input type="checkbox"/> Other (Specify below) _____ |
| <input checked="" type="checkbox"/> PVC | <input type="checkbox"/> ABS      | <input type="checkbox"/> Asbestos-Cement | <input type="checkbox"/> Concrete Tile |  |

Blank casing diameter 2 in. Was casing pulled? Yes  No  If yes, how much 20  
 Casing height above or below land surface 30 in.

**6 GROUT PLUG MATERIAL:**  Neat cement  Cement grout  Bentonite  Other \_\_\_\_\_

Grout Plug Intervals: From 0 ft. to 20 ft., From \_\_\_\_\_ ft. to \_\_\_\_\_ ft., From \_\_\_\_\_ ft. to \_\_\_\_\_ ft.  
*17.5*

What is the nearest source of possible contamination:

|   |   |   |   |
|---|---|---|---|
| <input type="checkbox"/> Septic tank            | <input type="checkbox"/> Seepage pit    | <input type="checkbox"/> Fuel storage         | <input checked="" type="checkbox"/> Other (specify below) |
| <input type="checkbox"/> Sewer lines            | <input type="checkbox"/> Pit privy      | <input type="checkbox"/> Fertilizer storage   | <u>Pipeline</u>   |
| <input type="checkbox"/> Watertight sewer lines | <input type="checkbox"/> Sewage lagoon  | <input type="checkbox"/> Insecticide storage  |   |
| <input type="checkbox"/> Lateral lines          | <input type="checkbox"/> Feedyard       | <input type="checkbox"/> Abandoned water well | Direction from well? <u>SE</u>                            |
| <input type="checkbox"/> Cess pool              | <input type="checkbox"/> Livestock pens | <input type="checkbox"/> Oil well/Gas well    | How many feet? <u>20</u>                                  |

| FROM | TO | PLUGGING MATERIALS | FROM | TO | PLUGGING MATERIALS |
|------|----|--------------------|------|----|--------------------|
|      |    |                    |      |    |                    |
|      |    |                    |      |    |                    |
**7 CONTRACTOR'S OR LANDOWNER'S CERTIFICATION:** This water well was plugged under my jurisdiction and was completed on (mo/day/year) 08/31/2017 and this record is true to the best of my knowledge and belief. Kansas Water Well Contractor's License No. 728. This Water Well Record was completed on (mo/day/year) 09/01/2017 under the business name of Impact7G by (signature) \_\_\_\_\_

Send one white copy to Kansas Department of Health & Environment, Geology Section, 1000 SW Jackson Street, Ste. 420, Topeka, KS 66612-1367. Send one copy to WATER WELL OWNER and retain one for your records.  
 Visit us at <http://www.kdheks.gov/waterwell/index.html> Telephone 785-296-5524.