

WATER WELL PLUGGING RECORD Form WWC-5P

KSA 82a-12121365609


#2

1 LOCATION OF WATER WELL: County: <u>Allen</u>	Fraction <u>SE 1/4 NE 1/4 NE 1/4 NE 1/4</u>	Section Number <u>30</u>	Township Number <u>24 T S</u>	Range Number <u>20</u> <input checked="" type="checkbox"/> E <input type="checkbox"/> W
--	--	-----------------------------	----------------------------------	--

Street/Rural Address of Well Location; if unknown, distance & direction from nearest town or intersection: If at owner's address, check here 3200th Street Moran, Kansas 66755

Global Positioning Systems (GPS) information:
 Latitude: 37.934603 (in decimal degrees)
 Longitude: 95.244130 (in decimal degrees)
 Elevation: 1049
 Datum: WGS84, NAD83, NAD27
 Collection Method:
 GPS unit (Make/Model: _____)
 Digital Map/Photo, Topographic Map, Land Survey
 Est. Accuracy: < 3 m, 3-5 m, 5-15 m, > 15 m

2 WATER WELL OWNER: Magellan Pipeline
 RR#, St. Address, Box #: One Williams Plaza
 City, State ZIP Code: Tulsa OK 74172

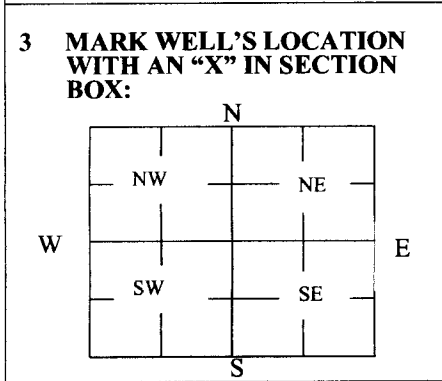

4 DEPTH OF WELL 34 ft.
 WELL'S STATIC WATER LEVEL 3.34 ft
 WELL WAS USED AS:
 Domestic Public Water Supply Dewatering
 Irrigation Oil Field Water Supply Monitoring
 Feedlot Domestic (Lawn & Garden) Injection Well
 Industrial Air Conditioning Other _____
 Was a chemical/bacteriological sample submitted to Department? Yes No

5 TYPE OF BLANK CASING USED:
 Steel RMP (SR) Wrought Fiberglass Other (Specify below) _____
 PVC ABS Asbestos-Cement Concrete Tile
 Blank casing diameter 2 in. Was casing pulled? Yes No If yes, how much 34
 Casing height above or below land surface 30 in.

6 GROUT PLUG MATERIAL: Neat cement Cement grout Bentonite Other _____
 Grout Plug Intervals: From 0 ft. to 31.5 ft., From _____ ft. to _____ ft., From _____ ft. to _____ ft.
 What is the nearest source of possible contamination:
 Septic tank Seepage pit Fuel storage Other (specify below) _____
 Sewer lines Pit privy Fertilizer storage Pipeline
 Watertight sewer lines Sewage lagoon Insecticide storage _____
 Lateral lines Feedyard Abandoned water well Se
 Cess pool Livestock pens Oil well/Gas well 53
 Direction from well? Se
 How many feet? 53

FROM	TO	PLUGGING MATERIALS	FROM	TO	PLUGGING MATERIALS

7 CONTRACTOR'S OR LANDOWNER'S CERTIFICATION: This water well was plugged under my jurisdiction and was completed on (mo/day/year) 08/31/2017 and this record is true to the best of my knowledge and belief. Kansas Water Well Contractor's License No. 728. This Water Well Record was completed on (mo/day/year) 09/01/2017 under the business name of Impact7G by (signature) _____

Send one white copy to Kansas Department of Health & Environment, Geology Section, 1000 SW Jackson Street, Ste. 420, Topeka, KS 66612-1367. Send one copy to WATER WELL OWNER and retain one for your records.
 Visit us at <http://www.kdheks.gov/waterwell/index.html> Telephone 785-296-5524.