


WATER WELL RECORD Form WWC-5 KSA 82a-1212

1 LOCATION OF WATER WELL: Fraction Section Number Township Number Range Number  
 COUNTY: HODGEMAN SE 1/4 NE 1/4 NE 1/4 23 T 24 S R 23 E

Distance and direction from nearest town or city street address of well if located within city?  
 FROM JETMORE ON SOUTH 283 TO RD R, EAST 5 M TO RD 223-5 1/4M

2 WATER WELL OWNER: WHITESIDE, REX Board of Agriculture, Division of Water Resources  
 RR#, St. Address, Box #: 1418 HIGHLAND TERRACE Application Number:  
 City, State, ZIP code: DODGE CITY, KS 67801-

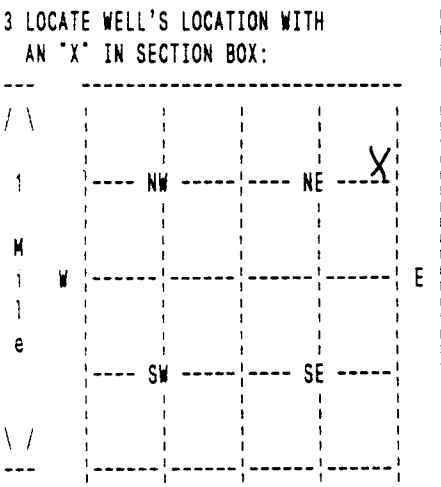

4 DEPTH OF COMPLETED WELL 265 ELEVATION: 0  
 Depth(s) Groundwater Encountered 1. 0 ft. 2. 0 ft. 3. 0 ft.  
 WELL'S STATIC WATER LEVEL 50 ft. below land surface measured on mo/day/yr 04/23/07  
 Pump testdata: Well water was 0 ft. after 0 hours pumping 0 gpm  
 Estimated Yield 50 gpm: Well water was 0 ft. after 0 hours pumping 0 gpm  
 Bore Hole Diameter 9 in. to 265 ft., and in. to 0 ft.  
 WELL WATER TO BE USED AS: DOMESTIC  
 Was a chemical/bacteriological sample submitted to department? No ;  
 If yes, mo/day/yr sample was submitted Water well disinfected? Yes

5 TYPE OF BLANK CASING USED: CERTA LOC CASIN CASING JOINTS: CERTA-LOC  
 Blank casing diameter 5 in. to 265 ft., Dia in. to 0 ft., Dia in. to 0 ft.  
 Casing height above land surface 12 in., weight 200 lbs/ft. Wall thickness or gauge No. 21  
 TYPE OF SCREEN OR PERFORATION MATERIAL: PVC  
 SCREEN OR PERFORATION OPENINGS ARE: SAW CUT

SCREEN PERFORATED INTERVALS: From 200 ft. to 260 ft., From 0 ft. to 0 ft.  
 From 0 ft. to 0 ft., From 0 ft. to 0 ft.  
 GRAVEL PACK INTERVALS: From 27 ft. to 265 ft., From 0 ft. to 0 ft.  
 From 0 ft. to 0 ft., From 0 ft. to 0 ft.

6 GROUT MATERIAL BENTONITE  
 Grout Intervals: From 6 ft. to 27 ft., From 0 ft. to 0 ft., From 0 ft. to 0 ft.  
 What is the nearest source of possible contamination: ABANDONED WELL  
 Direction from well? NORTHWEST How many feet? 15

FROM	TO	LITHOLOGIC LOG	FROM	TO	PLUGGING INTERVALS
0	25	01 TOPSOIL 05 CLAY			
25	30	37 FIN-COAR SAM			
30	40	16 GRAY CLAY 36 BLUE CLAY			
40	43	10 FINE-MEDSAND			
43	60	16 GRAY CLAY 36 BLUE CLAY 26 RED CLAY			
60	120	16 GRAY CLAY 26 RED CLAY			
120	140	16 GRAY CLAY			
140	160	08 ROCK LAYERS 16 GRAY CLAY			
160	180	16 GRAY CLAY 24 THINROCLAYER 29 SANDSTONE			
180	200	29 SANDSTONE 16 GRAY CLAY			

7 CONTRACTOR'S OR LANDOWNER'S CERTIFICATION: This water well was Constructed under my jurisdiction and was completed on (mo/day/year) 04/25/07 and this record is true to the best of my knowledge and belief. Kansas Water Well Contractor's License No. 179 This Water Well Record was completed on (mo/day/yr) 05/02/07 under the business name of JOE'S WELL SERVICE, INC. by (signature) *Judith Cook*

(Continued)

WATER WELL RECORD Form WWC-5 KSA 82a-1212

1 LOCATION OF WATER WELL: COUNTY: HODGEMAN	Fraction SE 1/4 NE 1/4 NE 1/4	Section Number 23	Township Number T 24 S	Range Number R 23 E
---	----------------------------------	----------------------	---------------------------	------------------------

2 WATER WELL OWNER: RR#, St. Address, Box #: 1418 HIGHLAND TERRACE City, State, ZIP code: DODGE CITY, KS 67801-	WHITESIDE, REX Board of Agriculture, Division of Water Resources Application Number:
---	--

FROM	TO	LITHOLOGIC LOG
200	260	29 SANDSTONE
260	280	16 GRAY CLAY 08 ROCK LAYERS

7 CONTRACTOR'S OR LANDOWNER'S CERTIFICATION: This water well was Constructed under my jurisdiction and was completed on (mo/day/year) 04/25/07 and this record is true to the best of my knowledge and belief. Kansas Water Well Contractor's License No. 179 This Water Well Record was completed on (mo/day/yr) 05/02/07 under the business name of JOE'S WELL SERVICE, INC. by (signature) *Judith Crick*