


1 LOCATION OF WATER WELL: Butler	FRACTION NE 1/4 NE 1/4 SW 1/4	Section Number 18	Township Number T 24 S	Range Number R 3E E/W
--	---	-----------------------------	----------------------------------	---------------------------------

Distance and direction from nearest town or city street address of well if located within city?

303 S. Oak Whitewater, Kansas

WATER WELL OWNER: WISDOM, Virgil	Board of Agriculture, Division of Water Resource
RR#, ST. ADDRESS, BOX #: 303 S. Oak	Application Number:
CITY, STATE, ZIP CODE: Whitewater, Kansas	

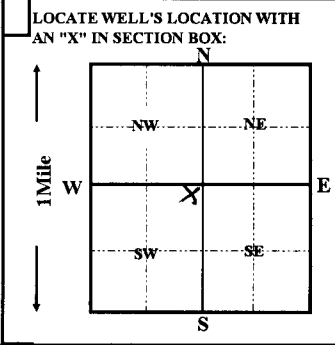

4 DEPTH OF COMPLETED WELL 82 ft.	ELEVATION:			
Depth(s) groundwater Encountered 1 ft.	2 ft.	3 ft.	ft.	ft.
WELL'S STATIC WATER LEVEL 20 FT. BELOW LAND SURFACE MEASURED ON 08/10/2000				
Pump test data: Well water was ft. after hours pumping gpm				
Est. Yield gpm: Well water was ft. after hours pumping gpm				
Bore Hole Diameter 12 in. to 82 ft. and in. to ft.				
WELL WATER TO BE USED AS: 5 Public water supply 8 Air conditioning 11 Injection well				
1 Domestic 3 Feedlot 6 Oil field water supply 9 Dewatering 12 Other (Specify below)				
2 Irrigation 4 Industrial 7 Lawn and garden only 10 Monitoring well				
Was a chemical/bacteriological sample submitted to Department? Yes <input type="checkbox"/> No <input checked="" type="checkbox"/> ; If yes, mo/day/yr sample was submitted				
Water Well Disinfected? Yes <input checked="" type="checkbox"/> No <input type="checkbox"/>				

5 TYPE OF CASING USED:	3 RMP (SR)	5 Wrought iron	8 Concrete tile	CASING JOINTS: Glued <input checked="" type="checkbox"/> Clamped
1 Steel	4 ABS	6 Asbestos-Cement	9 Other (Specify below)	Welded
2 PVC		7 Fiberglass	SDR - 26	Threaded
Blank casing Diameter 5 in. to 24 ft., Dia	in. to ft.	weight 2.35 lbs. / ft.	Wall thickness or gauge No. .214	
Casing height above land surface 12 in.				
TYPE OF SCREEN OR PERFORATION MATERIAL:				
1 Steel	3 Stainless steel	5 Fiberglass	8 RMP (SR)	11 other (specify)
2 Brass	4 Galvanized steel	6 Concrete tile	9 ABS	12 None used (open hole)
SCREEN OR PERFORATION OPENING ARE:				
1 Continous slot	3 Mill slot	5 Gauzed wrapped	8 Saw cut	11 None (open hole)
2 Louvered shutter	4 Key punched	6 Wire wrapped	9 Drilled holes	
3 Torch cut			10 Other (specify)	
SCREEN-PERFORATION INTERVALS: from 24 ft. to 82 ft., From ft. to ft.				
GRAVEL PACK INTERVALS: from 24 ft. to 82 ft., From ft. to ft.				

6 GROUT MATERIAL: 1 Neat cement	2 Cement grout	3 Bentonite	4 Other bentonite hole plug
Grout Intervals: From ft. to ft.	From ft. to ft.	From ft. to ft.	From 4 ft. to 24 ft.
What is the nearest source of possible contamination:			
1 Septic tank	4 Lateral lines	7 Pit privy	10 Livestock pens
2 Sewer lines	5 Cess pool	8 Sewage lagoon	11 Fuel storage
3 Watertight sewer lines	6 Seepage pit	9 Feedyard	12 Fertilizer storage
			13 Insecticide storage
			14 Abandon water well
			15 Oil well/Gas well
			16 Other (specify below)

Direction from well? **West** How many feet? **30**

FROM	TO	LITHOLOGIC LOG	FROM	TO	PLUGGING INTERVALS
0	4	topsoil			
4	18	clay			
18	25	fine sand			
25	30	clay			
30	35	medium fine sand			
35	55	shale			
55	82	limestone			

7 CONTRACTOR'S OR LANDOWNER'S CERTIFICATION: This water well was (1) constructed, (2) reconstructed, or (3) plugged under my jurisdiction and was completed on (mo/day/year) 08/10/00 and this record is true to the best of my knowledge and belief. Kansas Water Well Contractor's License No. 236 This Water Well Record was completed on (mo/day/yr) 08/16/00	Under the business name of Harp Well & Pump Service, Inc. by (signature) <i>Todd S. Harp</i>
--	--