


1 LOCATION OF WATER WELL: Fraction SE 1/4 SE 1/4 NW 1/4 Section Number 18 Township Number T 24 S Range Number R 3 EDW  
 County: Butler

Distance and direction from nearest town or city street address of well if located within city?

317 Elm St White Water

2 WATER WELL OWNER: Gene Atwood  
 RR#, St. Address, Box #: 317 Elm St  
 City, State, ZIP Code: White Water, KS 67154  
 Board of Agriculture, Division of Water Resources  
 Application Number:

3 LOCATE WELL'S LOCATION WITH AN "X" IN SECTION BOX: 4 DEPTH OF COMPLETED WELL: 48 ft. ELEVATION:

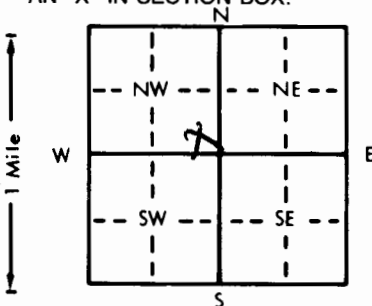

Depth(s) Groundwater Encountered 1. 17 ft. 2. 17 ft. 3. 17 ft.  
 WELL'S STATIC WATER LEVEL 17 ft. below land surface measured on mo/day/yr 11-19-84  
 Pump test data: Well water was 47 ft. after 1 1/2 hours pumping 20 gpm  
 Est. Yield 20 gpm: Well water was 47 ft. after 1 1/2 hours pumping 20 gpm  
 Bore Hole Diameter 11 in. to 48 ft., and 48 in. to 48 ft.  
 WELL WATER TO BE USED AS:  
 5 Public water supply 8 Air conditioning 11 Injection well  
 1 Domestic 3 Feedlot 6 Oil field water supply 9 Dewatering 12 Other (Specify below)  
 2 Irrigation 4 Industrial 7 Lawn and garden only 10 Observation well  
 Was a chemical/bacteriological sample submitted to Department? Yes X No X; If yes, mo/day/yr sample was submitted  
 Water Well Disinfected? Yes X No

5 TYPE OF BLANK CASING USED:  
 1 Steel 3 RMP (SR) 5 Wrought iron 8 Concrete tile CASING JOINTS: Glued X Clamped  
2 PVC 4 ABS 6 Asbestos-Cement 9 Other (specify below) Welded  
 7 Fiberglass Threaded  
 Blank casing diameter 5 in. to 20 ft., Dia. 5 in. to 20 ft., Dia. 5 in. to 20 ft.  
 Casing height above land surface 18 in., weight 3.36 lbs./ft. Wall thickness or gauge No. 22.5

TYPE OF SCREEN OR PERFORATION MATERIAL:  
 1 Steel 3 Stainless steel 5 Fiberglass 8 RMP (SR) 10 Asbestos-cement  
 2 Brass 4 Galvanized steel 6 Concrete tile 9 ABS 11 Other (specify)  
 12 None used (open hole)

SCREEN OR PERFORATION OPENINGS ARE:  
 1 Continuous slot 3 Mill slot 5 Gauzed wrapped factory 8 Saw cut 1025 11 None (open hole)  
 2 Louvered shutter 4 Key punched 6 Wire wrapped 9 Drilled holes  
 7 Torch cut 10 Other (specify)

SCREEN-PERFORATED INTERVALS: From 20 ft. to 40 ft., From 40 ft. to 48 ft.  
 GRAVEL PACK INTERVALS: From 10 ft. to 48 ft., From 48 ft. to 48 ft.

6 GROUT MATERIAL: 1 Neat cement 2 Cement grout 3 Bentonite 4 Other  
 Grout Intervals: From 0 ft. to 10 ft., From 10 ft. to 48 ft., From 48 ft. to 48 ft.

What is the nearest source of possible contamination:  
 1 Septic tank 4 Lateral lines 7 Pit privy 10 Livestock pens 14 Abandoned water well  
2 Sewer lines 5 Cess pool 8 Sewage lagoon 11 Fuel storage 15 Oil well/Gas well  
 3 Watertight sewer lines 6 Seepage pit 9 Feedyard 12 Fertilizer storage 16 Other (specify below)  
 13 Insecticide storage  
 Direction from well? So How many feet? 50'

FROM	TO	LITHOLOGIC LOG	FROM	TO	LITHOLOGIC LOG
<u>0</u>	<u>5</u>	<u>loam # fill dirt</u>			
<u>5</u>	<u>11</u>	<u>light grey clay - sandy seams</u>			
<u>11</u>	<u>20</u>	<u>tan clay - sandy</u>			
<u>20</u>	<u>24</u>	<u>med sand</u>			
<u>24</u>	<u>30</u>	<u>red # green shale</u>			
<u>30</u>	<u>48</u>	<u>grey shale</u>			
		<u>fault at 36'</u>			

7 CONTRACTOR'S OR LANDOWNER'S CERTIFICATION: This water well was (1) constructed, (2) reconstructed, or (3) plugged under my jurisdiction and was completed on (mo/day/year) 11-19-84 and this record is true to the best of my knowledge and belief. Kansas Water Well Contractor's License No. 457 This Water Well Record was completed on (mo/day/yr) 12-1-84 under the business name of UWWP by (signature) Paul B...

INSTRUCTIONS: Use typewriter or ball point pen, PLEASE PRESS FIRMLY and PRINT clearly. Please fill in blanks, underline or circle the correct answers. Send top three copies to Kansas Department of Health and Environment, Division of Environment, Environmental Geology Section, Topeka, KS 66620. Send one to WATER WELL OWNER and retain one for your records.