

1 LOCATION OF WATER WELL  
 County: BUTLER Fraction: 1/4 Section Number: 18 Township Number: T 24 S Range Number: R 43 EW  
 Distance and direction from nearest town or city? IN Whitewater, Ks. Street address of well if located within city? 320 N. Oak - Whitewater, Ks.

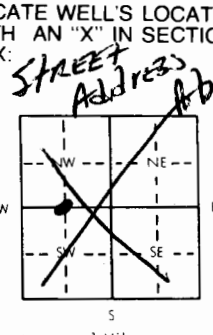
2 WATER WELL OWNER: Linda Ravenschraft  
 RR#, St. Address, Box #: 320 N. Oak Board of Agriculture, Division of Water Resources  
 City, State, ZIP Code: Whitewater, Ks. Application Number: \_\_\_\_\_

3 DEPTH OF COMPLETED WELL: 65 ft. Bore Hole Diameter: 9 in. to 65 ft., and \_\_\_\_\_ in. to \_\_\_\_\_ ft.  
 Well Water to be used as:  
 1 Domestic 3 Feedlot 6 Oil field water supply 9 Dewatering 12 Other (Specify below)  
 2 Irrigation 4 Industrial 7 Lawn and garden only 10 Observation well  
 Well's static water level: 15 ft. below land surface measured on Aug month 14 day 1980 year  
 Pump Test Data: Well water was 20 ft. after 1 hours pumping 20 gpm  
 Est. Yield 20 gpm: Well water was \_\_\_\_\_ ft. after \_\_\_\_\_ hours pumping \_\_\_\_\_ gpm

4 TYPE OF BLANK CASING USED:  
 1 Steel 3 RMP (SR) 6 Asbestos-Cement 9 Other (specify below) Casing Joints: Glued \_\_\_\_\_ Clamped \_\_\_\_\_  
2 PVC 4 ABS 7 Fiberglass \_\_\_\_\_ Welded   
 Blank casing dia: 5 in. to 65 ft., Dia \_\_\_\_\_ in. to \_\_\_\_\_ ft., Dia \_\_\_\_\_ in. to \_\_\_\_\_ ft.  
 Casing height above land surface: 18 in., weight 200 lbs./ft. Wall thickness or gauge No. \_\_\_\_\_  
 TYPE OF SCREEN OR PERFORATION MATERIAL:  
 1 Steel 3 Stainless steel 5 Fiberglass 7 PVC 10 Asbestos-cement  
 2 Brass 4 Galvanized steel 6 Concrete tile 9 ABS 11 Other (specify) \_\_\_\_\_  
 12 None used (open hole)  
 Screen or Perforation Openings Are:  
1 Continuous slot 3 Mill slot 5 Gauzed wrapped 8 Saw cut 11 None (open hole)  
 2 Louvered shutter 4 Key punched 6 Wire wrapped 9 Drilled holes 10 Other (specify) \_\_\_\_\_  
 Screen-Perforation Dia: \_\_\_\_\_ in. to \_\_\_\_\_ ft., Dia \_\_\_\_\_ in. to \_\_\_\_\_ ft., Dia \_\_\_\_\_ in. to \_\_\_\_\_ ft.  
 Screen-Perforated Intervals: From 20 ft. to 40 ft., From \_\_\_\_\_ ft. to \_\_\_\_\_ ft., From \_\_\_\_\_ ft. to \_\_\_\_\_ ft.  
 From 50 ft. to 60 ft., From \_\_\_\_\_ ft. to \_\_\_\_\_ ft., From \_\_\_\_\_ ft. to \_\_\_\_\_ ft.  
 Gravel Pack Intervals: From 10 ft. to 65 ft., From \_\_\_\_\_ ft. to \_\_\_\_\_ ft., From \_\_\_\_\_ ft. to \_\_\_\_\_ ft.  
 From \_\_\_\_\_ ft. to \_\_\_\_\_ ft., From \_\_\_\_\_ ft. to \_\_\_\_\_ ft., From \_\_\_\_\_ ft. to \_\_\_\_\_ ft.

5 GROUT MATERIAL: 1 Neat cement 2 Cement grout 3 Bentonite 4 Other \_\_\_\_\_  
 Grouted Intervals: From Top ft. to 10 ft., From \_\_\_\_\_ ft. to \_\_\_\_\_ ft., From \_\_\_\_\_ ft. to \_\_\_\_\_ ft.  
 What is the nearest source of possible contamination:  
 1 Septic tank 4 Cess pool 7 Sewage lagoon 11 Fertilizer storage 15 Oil well/Gas well  
 2 Sewer lines 5 Seepage pit 8 Feed yard 12 Insecticide storage 16 Other (specify below)  
 3 Lateral lines 6 Pit privy 9 Livestock pens 13 Watertight sewer lines  
 Direction from well: North How many feet: 40 ? Water Well Disinfected? Yes  No \_\_\_\_\_  
 Was a chemical/bacteriological sample submitted to Department? Yes \_\_\_\_\_ No  If yes, date sample was submitted \_\_\_\_\_ month \_\_\_\_\_ day \_\_\_\_\_ year: Pump Installed? Yes \_\_\_\_\_ No \_\_\_\_\_  
 If Yes: Pump Manufacturer's name: Gould Model No. \_\_\_\_\_ HP 1/3 Volts 110  
 Depth of Pump Intake: 55 ft. Pumps Capacity rated at 10 gal./min.  
 Type of pump: 1 Submersible 2 Turbine 3 Jet 4 Centrifugal 5 Reciprocating 6 Other \_\_\_\_\_

6 CONTRACTOR'S OR LANDOWNER'S CERTIFICATION: This water well was (1) constructed, (2) reconstructed, or (3) plugged under my jurisdiction and was completed on August month 16 day 1980 year and this record is true to the best of my knowledge and belief. Kansas Water Well Contractor's License No. 221  
 This Water Well Record was completed on Nov month 10 day 1980 year under the business name of \_\_\_\_\_ by (signature) Frank Budch

7 LOCATE WELL'S LOCATION WITH AN "X" IN SECTION BOX:  
  

FROM	TO	LITHOLOGIC LOG	FROM	TO	LITHOLOGIC LOG
0	5	Top soil			
5	25	Brown clay			
25	40	Sand			
40	50	Blue shale			
50	53	Sandy blue			
53	45	Blue shale			

ELEVATION:  
 Depth(s) Groundwater Encountered 1. 15 ft. 2. 53 ft. 3. \_\_\_\_\_ ft. 4. \_\_\_\_\_ ft. (Use a second sheet if needed)

INSTRUCTIONS: Use typewriter or ball point pen, please press firmly and PRINT clearly. Please fill in blanks, underline or circle the correct answers. Send top three copies to Kansas Department of Health and Environment, Division of Environment, Water Well Contractors, Topeka, KS 66620. Send one to WATER WELL OWNER and retain one for your records.